



CERTIFIED LAND CORNER RESTORATION

Index No. 7-10

State of Wisconsin }
County of Oneida } ss.

I Phillip T. Hansen, do hereby certify that on the 23rd day of June, 1980, I ~~know~~ established the W.C. 1/16 corner of Section 28 Township 37, North, Range 11 East, Fourth Principal Meridian, as described hereon; and that from this evidence I established a new monument and accessories as described hereon to perpetuate the original location of this corner.

Resident witnesses:
Glen Barker
Jim Clafflin
Herb Wagoner

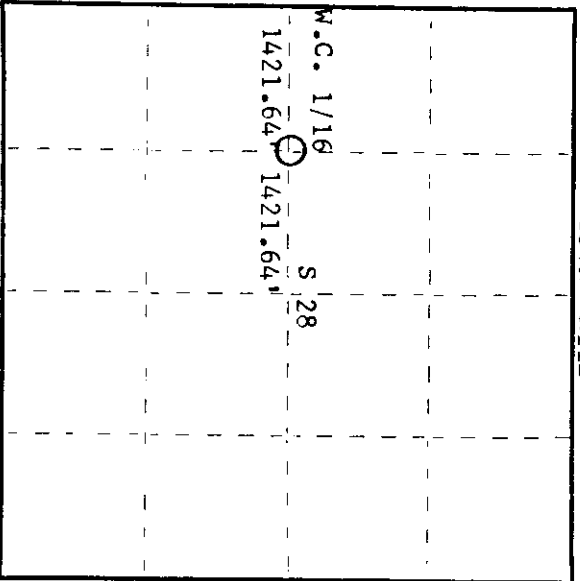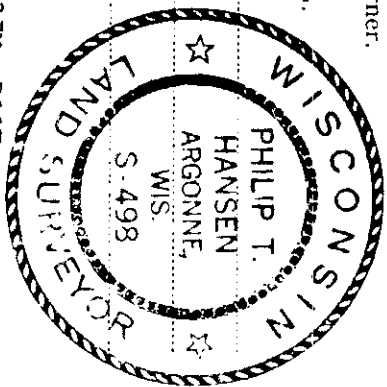

○ = Corner monument restored.

History of original corner establishment:

No record of any previous survey.

Description of corner evidence found:

No evidence of any corner recovered.

Corner established by traverse and computation.

Ran traverse from N 1/4 corner to S 1/4 corner and E 1/4 to W 1/4 to establish the C 1/4 corner.

Set W.C. 1/16 corner at 1421.64 feet S 89° 00' 59" E intermediate between C 1/4 corner and W 1/4 corner.

Description of monument and accessories I established to perpetuate the original location of this corner.

Set a 1-1/2" iron pipe with 2" brass cap projecting 18" above ground, cap stamped:

Marked NBR's -

Cedar 9" due West 16.98 ft.

Cedar 7" S9°W 16.90 ft.

scribed 1/16 B.T.

S498
T37N R11E
W.C. 1/16 S 28
CPI-1980

Dated at Rhineland, Wis., this 23rd day of July, 1980

Signature Phillip T. Hansen, Title, Registered Land Surveyor Registration No. S-498
(County Surveyor, Registered Land Surveyor, or other duly authorized official)

Office of Register of Deeds, County of Oneida, I hereby certify that the within instrument was filed in this office for record on the 30th day of July, 1980 at 10:15 o'clock A.M.

Louis George Kuehn
(Register of Deeds)

By Louis George Kuehn Deputy

3711282030