

CERTIFIED LAND CORNER RESTORATION



Index No. **V-9**

State of Wisconsin

County of Oneida } ss.

I Philip T. Hansen, do hereby certify that on the 31st day of March, 1975, I found evidence of the Section Corner corner of S28, S29, S32, and S33 Township 37, North, Range 11 East, Fourth Principal Meridian, as described hereon; and that from this evidence I established a new monument and accessories as described hereon to perpetuate the original location of this corner.

Resident witnesses:

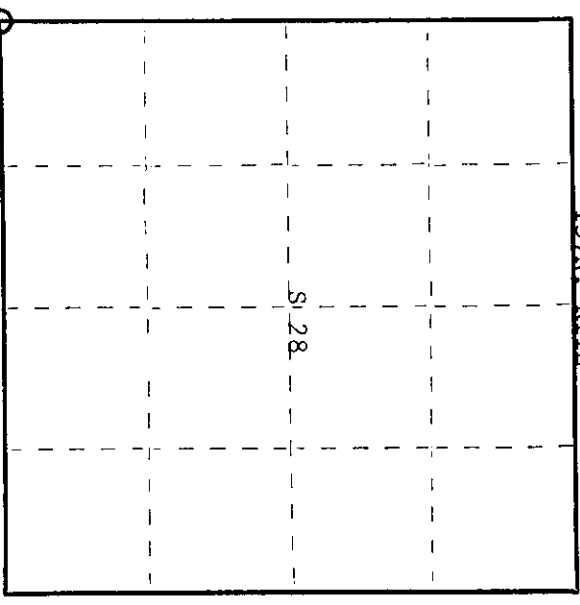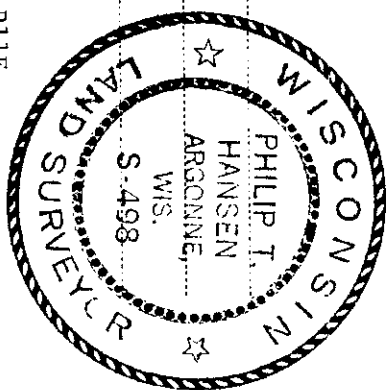

○ = Corner monument restored.

History of original corner establishment:
Original corner established by Wm. E. Dougherty, Government Deputy Surveyor, in 1859.

Tamarack 10" S43°W 15 links Tamarack 6" N45°E 10 links
Corner recovered by V.M. Maine, County Surveyor. Set 2-1/2" iron pipe with brass cap from which he established cedar 12" N23°E 6-1/2 links; cedar 10" N24½W 21 links; cedar 10" S39°W 23 links; and yellow birch 12" S20°E 54 links.

Corner recovered by H.C. Lawrence, Registered Land Surveyor, in 1959. Found iron pipe and bearing trees okay. Set new cedar post squared and scribed and set NBT yellow birch 18" N35°E 15-1/2 links.

Description of corner evidence found:

Recovered Maine's 2-1/2" iron pipe with brass cap stamped - S29 | S28
Recovered Lawrence's 4" cedar post, squared and scribed S28, S29, S32, S33, S32 | S33
in fair condition.

| | | | | | |
|-------------------|-------|-----------|---------|-----|------------------------------|
| OBT's - Cedar 13" | N23°E | 6½ links | scribed | S28 | BT |
| Cedar 11" | N60°W | 21 links | scribed | S29 | BT |
| Cedar 12" | S44°W | 23 links | scribed | S32 | BT |
| Yellow birch 12" | S20°E | 54 links | scribed | S33 | BT (dying - broken top) |
| Yellow birch 18" | N35°E | 15½ links | scribed | S28 | NBT (dead - just a 20' stub) |

Description of monument and accessories I established to perpetuate the original location of this corner.
No accessories established.

Dated at Rhinelander, Wis., this 9th day of May, 1975.

Signature Philip T. Hansen Title Registered Land Surveyor Registration No. S-498
County Surveyor, Registered Land Surveyor, or other duly authorized official

Office of Register of Deeds, County of Oneida, hereby certify that the within instrument was filed in this office for record on the 1st day of October, 1975 at 3:00 o'clock P. M.

Donna Verge Tucker
(Register of Deeds)

By _____ Deputy

3711290000