



CERTIFIED LAND CORNER RESTORATION

Index No. **7-8**

State of Wisconsin }
County of Oneida } ss.

I Philip T. Hansen do hereby certify that on the 30th day of August, 1976, I found evidence of the U.C. 1/16 corner of section 29 Township 37 North, Range 11 East, Fourth Principal Meridian, as described hereon; and that from this evidence I established a new monument and accessories as described hereon to perpetuate the original location of this corner.

Resident witnesses:
Jim Martin
Herb Wagoner

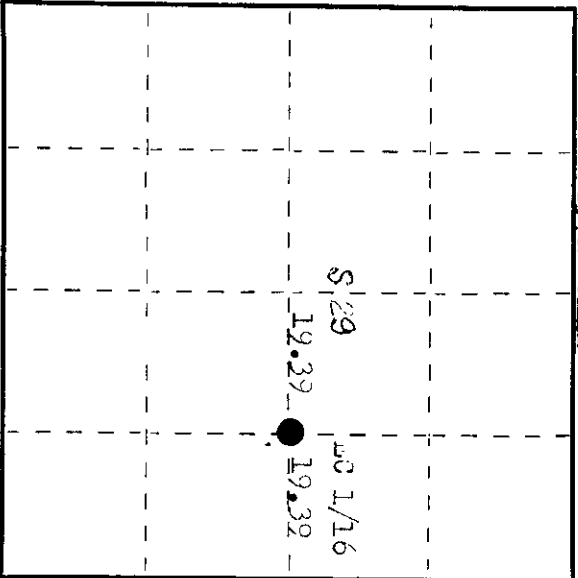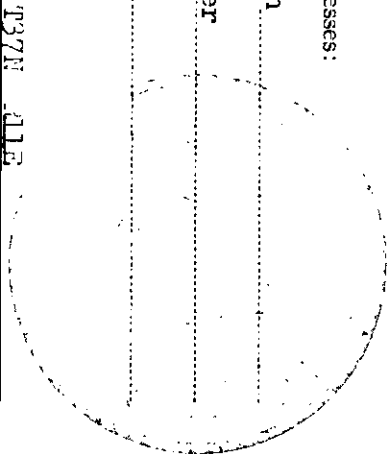

O = Corner monument restored.

History of original corner establishment:

Corner established by proportion by H.C. Lawrence, registered Land Surveyor, in 1951. Ran the random line west from east 1/4, to a 1/4, set the U 1/4 corner on corrected line which checked with D.H. Vaughan's recovered BT's established in 1906. Distance from C 1/4 to a 1/4 was 38.73 chains. Set U.C. 1/16 at 19.39 chains equidistant. Marked U.P.'s - Tamarack 10" H 33" E 41 links and Tamarack 6" S 25° E 44 links.

Description of corner evidence found:

Recovered H.C. Lawrence's 4" x 3" cedar post, squared and scribed U.C. 1/16 U 29 in poor condition.
Recovered U.P.'s - Tamarack 10" H 33° E 41.0 links, scribed BT - now dead.
Tamarack 6" (7") S 25° E 44 links, scribed BT.

Description of monument and accessories I established to perpetuate the original location of this corner.
replaced cedar post with 1 1/2" ID iron pipe with 2" brass cap stamped:
monument projects 18" above ground. 498
N 87° - Tamarack 6" H 62° E 26.7 links, scribed 1/16 BT. 1937N 41E
monument and U.P.'s painted blue. U.C. 1/16 U 29
JTI-1976

Dated at Oneida, Wis., this 7th day of September, 1976

Signature *Philip T. Hansen* Title Registered Land Surveyor Registration No. 498
(County Surveyor, Registered Land Surveyor, or other duly authorized official)

Office of Register of Deeds, County of Oneida
Instrument was filed in this office for record on the 9th day of November, 1976
at 10:30 o'clock A.M. I hereby certify that the within

Signature *Lorva George Kuehn*
(Register of Deeds)

By Deputy

3711292010