

CERTIFIED LAND CORNER RESTORATION

Index No. **5-5**

State of Wisconsin

County of Oneida } ss.



I Phillip F. Hansen, do hereby certify that on the 11th day of September, 1976, I found evidence of the corner of section 27 and 30 Township 37 North, Range 11 East, Fourth Principal Meridian, as described hereon; and that from this evidence I established a new monument and accessories as described hereon to perpetuate the original location of this corner.

Resident witnesses:

Glen Barker

Jim Claffin

Herb Wagoner

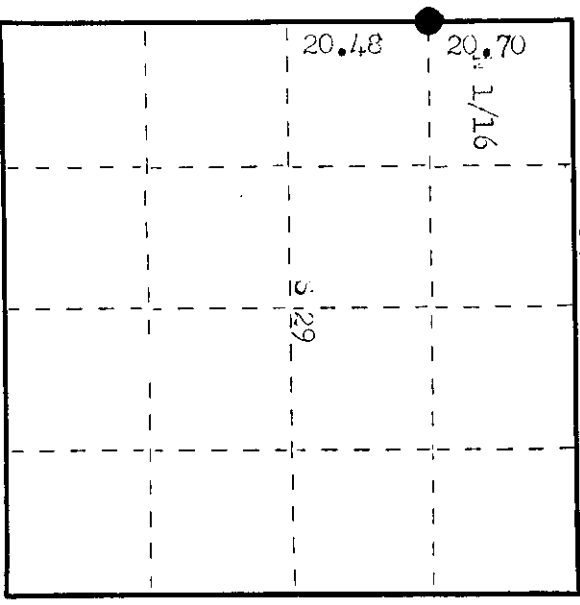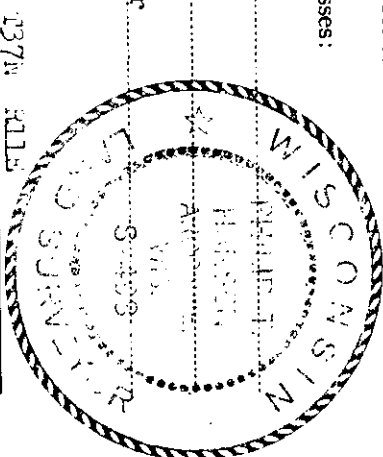

O = Corner monument restored.

History of original corner establishment: Corner est. believed by J. J. Dorr, County Surveyor. Set wood post and marked line 30' x 5' x 2 links. The 1/16 of line run by D. H. Vaughan in 1909; total distance his survey was 41.18 chains. Corner recovered by H. C. Lawrence, registered land surveyor, in 1921. Recorded distance was also 41.18 chains. Evident distance for a 1/16 should have been 20.59 chains, but he recovered Dorr's point of old square at 20.48 north, and found Dorr's old pine stump with scribbled legible. As this corner had been accepted for many years, replaced point of Dorr's stake with new cedar post and marked with white birch 5' x 5' x 10 links.

Description of corner evidence found:

Recovered Lawrence's 5' cedar post, squared and scribed 1/16, 29 - 1/16, 30 in fair condition, with a small rock cairn around base. Recovered Lawrence's 5' - white birch 5' (3') x 5' x 10 links, scribed 1/16, 29. Recovered Dorr's 5' - white birch 5' x 5' x 10 links, scribed 1/16, 29 still visible. Dorr's 5' - white birch 5' x 5' x 10 links, scribed 1/16, 29 still visible.

Description of monument and accessories I established to perpetuate the original location of this corner.

Replaced cedar post with 1 1/2" iron pipe with 2" brass cap stamped: Monument projects 24" above ground. 137A, 498  
1/16's - white ash 3" x 63° - 72.5 links, scribed 1/16, 29  
white ash 3" x 73° - 55.1 links, scribed 1/16, 29  
Placed rock cairn around base of monument.  
Painted monument and 5' x 5' blue. 137A, 411A  
UPI-1975

Dated at Oneida, Wis., this 7th day of September, 1976

Signature: Phillip F. Hansen, Title: Registered Land Surveyor, County Surveyor, Registered Land Surveyor, or other duly authorized official. Registration No. 3-478

Office of Register of Deeds, County of Oneida. I hereby certify that the within instrument was filed in this office for record on the 9th day of November, 1976 at 10:30 o'clock A.M.

Signature: Anne George Fischer, (Register of Deeds)

By: Deputy

3711303000