

CERTIFIED LAND CORNER RESTORATION

Index No. A-4

State of Wisconsin

County of Oneida } ss.

History of original corner establishment:
Original corner established by B.F. Dorr, County Surveyor. H.C. Lawrence recovered Dorr's post in 1947. Set 6" cedar post and marked NBT - Maple 16" N7°W 50 links


I Phillip T. Hansen, do hereby certify that on the 14th day of November, 1975, I found evidence of the E-1/16 corner of Sections 6 and 31 Township 36 and 37, North, Range 11 East, Fourth Principal Meridian, as described hereon; and that from this evidence I established a new monument and accessories as described hereon to perpetuate the original location of this corner.

Description of corner evidence found:
Recovered Lawrence's 6" cedar post, squared and scribed S6 E-1/16 S31, in poor condition. Also recovered old squared stake lying beside it. Recovered OBT - Maple 16"(20") N7°W 50 links - scribed E-1/16 S31 BT

Resident witnesses:

Glen Barker

Jim CLAFLIN

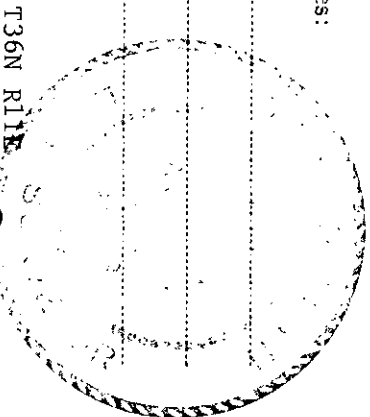

T36N R11E


E-1/16

Description of monument and accessories I established to perpetuate the original location of this corner.
Replaced Lawrence's 6" cedar post with 1" OD iron pipe with 2" brass cap stamped -
Set Lawrence's old post beside it.
Pipe projects 18" above ground.
NBT - W. Pine 12" N89°E 23 links - scribed 1/16 BT
Pipe, post, and BT's painted blue.

S498
T37N R11E

E-1/16 S 31
S 6

CPI - 1975

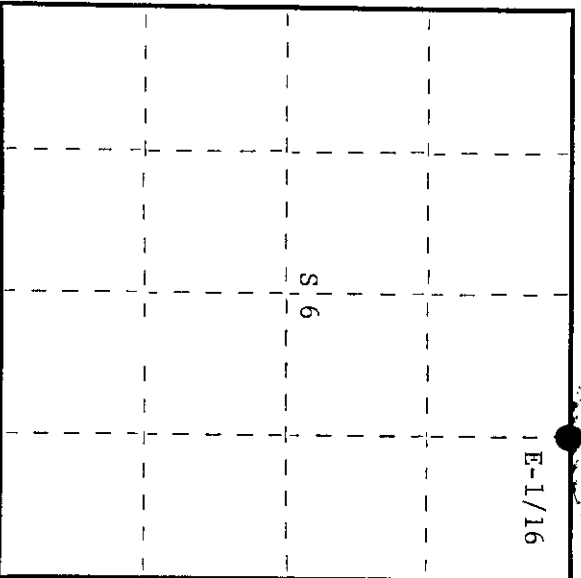

○ = Corner monument restored.

Dated at Rhineland, Wis., this 18th day of November, 1975

Signature Phillip T. Hansen Title Registered Land Surveyor Registration No. S-498
(County Surveyor, Registered Land Surveyor, or other duly authorized official)

Office of Register of Deeds, County of Oneida
Instrument was filed in this office for record on the 4th day of January, 1977
at 9:00 o'clock M. I hereby certify that the within

Leola George Kuehn
(Register of Deeds)

By Deputy