U.S. PUBLIC LAND SURVEY MONUMENT RECORD

Note: This form is intended and designed to fulfill all requirements of Wisconsin Administrative Code, Chapter A-E 7.08 U.S. Public Land Survey Monument Record (3)(a-i).

(a) CORNER LOCATION
1/4 Cor. of Secs. 5 & 32
Township 36 & 37 North
Range 11 East of the 4th P.M.
Town of Monico and Piehl
County of Oneida

WISCRS - Oneida County
N: 165,005.78 USft
E: 331,952.89 USft
Datum: NAD 83(2011)
GNSS Method: RTN - Direct
GNSS Control: WISCORS VRS

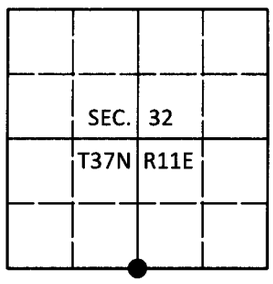

(b) HISTORY OF ORIGINAL CORNER ESTABLISHMENT

Original Surveyor: Hiram C. Fellows

Original Accessories:

Date of Survey Commenced: July, 1859
Completed: July, 1859

W. Pine 10" S14°W, 25 lks.
Spruce 10" N25°E, 40 lks.

(b)(f)(g)(h) Description of monument found at this corner and if it was accepted, state all evidence (material, testimonial, occupational, plats, records, other monuments) used as a basis for accepting. If not accepted or if nothing was found, state evidence used as basis for establishing location. If re-established through lost corner proportionate methods, indicate all monuments, distances and directions used to establish. Indicate type of monument and sign post found or set.

November 18, 1937: Notes by V.M. Maine in Maine book 1937A on page 257. "Gov't. 1/4 stake bet. Secs. 5 & 32 identified by orig. tree tipped over marks plain viz: Pine 10 S14W, .25; Stp. of Spr. 10 N25E, .40. Set official cor. New BTs viz: Bal. 9 N43E, .40; Bal. 9 S5W, .985"

July 17, 2018: I found and accepted the record monument, a 2-1/2" diam. iron pipe with a 2-1/2" diam. brass cap projecting 14" above the bog surface. The corner is located in a tag alder swale. I was unable to recover evidence of Maine's bearing trees, but using Maine's measurements the location of this monument agrees well with the corners to the West. I found or established accessories as shown below. I set a white vinyl sign post bearing Southeast, 0.8 ft.

The coordinate value shown has been verified by at least one of the following methods: 1) comparison to a previously GPS determined published value; 2) the value is the average of two or more GPS observations at a markedly different time; 3) one or more distances were measured back to the GPS observed corner from temporary GPS observed offset locations.

(c)(d)(e) Plan view of corner with ties to at least 4 witness monuments. If in disagreement with previously established corner, show the distances between the two corners and also indicate the ties to the disputed.

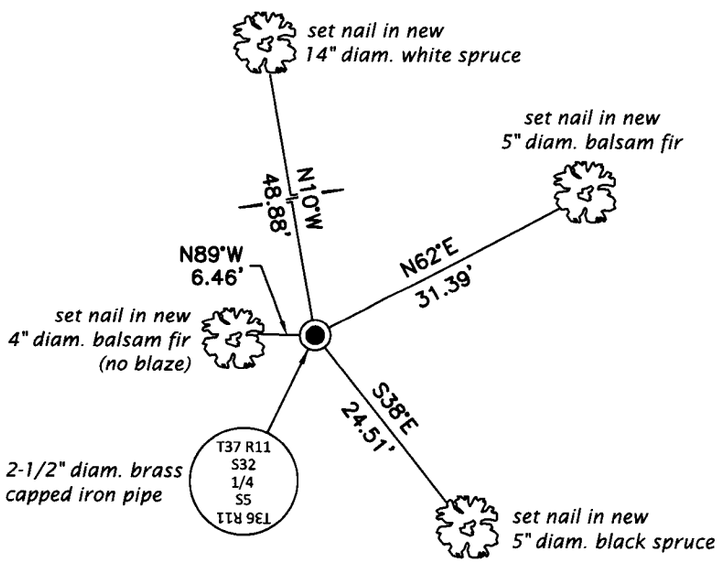

Magnetic
1" = 20'

WISCONSIN
JEFFREY W. AUSTIN
S-1885
MINOCQUA, WI
LAND SURVEYOR

REGISTER OF DEEDS OFFICE
ONEIDA COUNTY
FILED

AUG 16 2018

KYLE J. FRANSON
REGISTER OF DEEDS

(i) I, Jeffrey W. Austin, Professional Land Surveyor No. S-1885, hereby certify that the corner location on this record was determined by me or under my direction and control and that this U.S. Public Land Survey Monument Record is correct and complete to the best of my knowledge and belief.

Signature

AUG. 8, 2018
Date

3711320020 (INDEX NO. Z-7)