
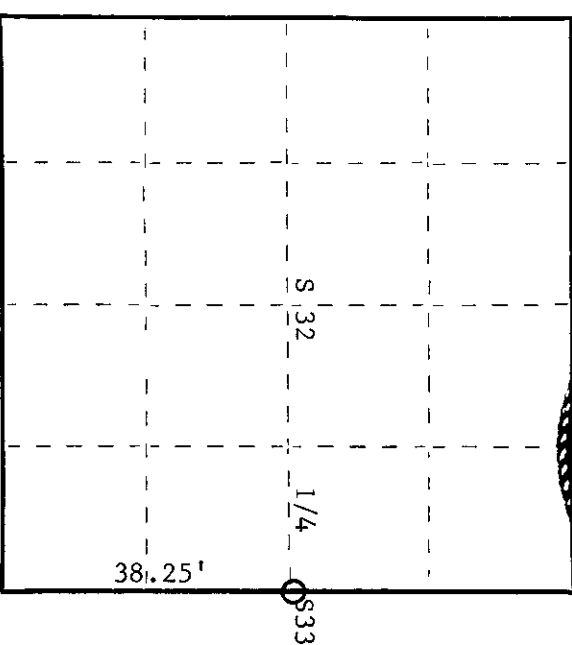


State of Wisconsin

County of Oneida } ss.

I Philip T. Hansen, do hereby certify that on the 14th day of April, 1975, I found evidence of the Quarter corner of Sections 32 and 33 Township 37 North, Range 11 East, Fourth Principal Meridian, as described hereon; and that from this evidence I established a new monument and accessories as described hereon to perpetuate the original location of this corner.

Resident witnesses:

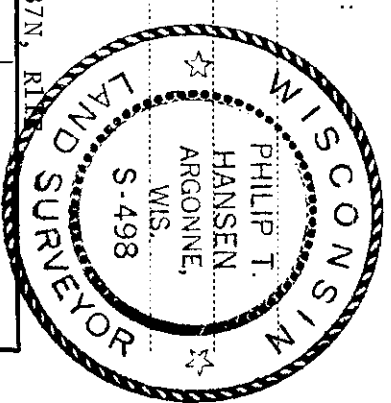

○ = Corner monument restored.

History of original corner establishment:
 Original corner set by Wm. E. Dougherty, Government Deputy Surveyor, in 1859.
 BT's - Tamarack 9", N70°W, 7 links; tamarack 9", N73°E, 5 links.

Corner re-established by H.C. Lawrence, Registered Land Surveyor, during retracement survey in 1958. He ran N130°E from re-established section corners 5, 4, 33, and 32 and at 5 chains observed a yellow birch with very old blazes on it. Offset to yellow birch and continued N6°30'W at 19.12 chains. V.M. Maine's S-1/16 corner was 96 links East. At 38.25 chains recovered Maine's 1/4 corner 192 links East. Corrected bearing of line N3°38'W. Set a 6" cedar post for 1/4 corner from which a dead tamarack 8" bears S35°E, 53 links; dead tamarack 10" bears N80°E, 59 links beside Maine's 2 1/2" iron pipe with brass cap.

Description of corner evidence found:
 Recovered H.C. Lawrence's 6" cedar post, squared and scribed 1/4-S Section 32, 1/4-S Section 33 in fair condition beside V.M. Maine's 2 1/2" iron pipe with brass cap stamped - T37N, R11E
 The pipe and post were leaning badly.
 The tamarack (dead) scribed 1/4 S33 had fallen down.
 No trace of 8" dead tamarack S35°E 53'.
 S32 1 1/4 S33
 M.

Description of monument and accessories I established to perpetuate the original location of this corner.
 Removed and reset 2 1/2" iron pipe in original hole.

- NBT's - Black spruce 8" N77°E 48 links scribed 1/4 BT
- Black spruce 7" N14°E 31 links scribed 1/4 BT

Dated at Rhinelander, Wis., this 28th day of April, 1975

Signature: *Philip T. Hansen* Title: Registered Land Surveyor Registration No. S-498
 (County Surveyor, Registered Land Surveyor, or other duly authorized official)
 Office of Register of Deeds, County of Oneida
 Instrument was filed in this office for record on the 1st day of October, 1975 at 3:00 o'clock P.M.

Doris George Truett
 (Register of Deeds)

By: Deputy