


CERTIFIED LAND CORNER RESTORATION

Y 10 Index No. Y-10

State of Wisconsin } ss.  
 County of Oneida }

I, Philip T. Hansen, do hereby certify that on the 14th day of April, 1975, I found evidence of the SW-1/16 corner of Section 33 Township 37 North, Range 11 East, Fourth Principal Meridian, as described hereon; and that from this evidence I established a new monument and accessories as described hereon to perpetuate the original location of this corner.

Resident witnesses:

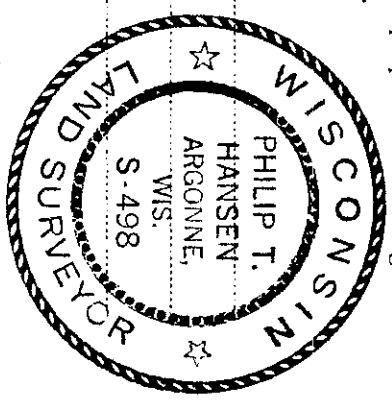


History of original corner establishment:  
 Corner established by H.C. Lawrence, Registered Land Surveyor, during his retracement and subdivision survey of 1958. Ran South 89°00'W from his established SC-1/16 corner 43.30 chains to intersect line between Sections 32 and 33, 36 links North of the S-1/16 corner. Set SW-1/16 corner at 21.65 chains, 18 links South of random. 5" cedar post from which cedar 14" bears N80°W, 48 links and a peaked boulder 3' high x 6' x 6' base bears N50°E, 37 links.

Description of corner evidence found:  
 Recovered H.C. Lawrence's 5" cedar post, squared and scribed SW-1/16 S33 SW-1/16, in good condition. Post had rock carron around it.  
 Recovered 14" cedar, N80°W, 48 links, scribed SW-1/16 BT. Also, 3' high x 6' x 6' boulder, N56°E, 37 links. There was a difference of 6° in this bearing.

Description of monument and accessories I established to perpetuate the original location of this corner.  
 Replaced 5" cedar post with 1 1/2" OD x 5' galvanized iron pipe with 2" brass cap stamped -

NBT - cedar 10" S70°W 15.5 links scribed 1/16 BT

S498  
 T37N, R11E  
 SW-1/16 S 33  
 CPI-1975

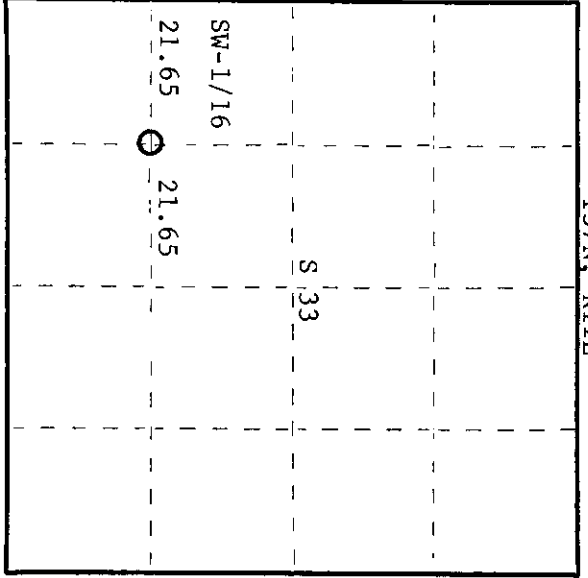

○ = Corner monument restored.

3711331030

Dated at Rhineland, Wis., this 25th day of April, 1975.

Signature: *Philip T. Hansen* Title: Registered Land Surveyor Registration No. S-498  
 (County Surveyor, Registered Land Surveyor, or other duly authorized official)  
 Office of Register of Deeds, County of Oneida  
 Instrument was filed in this office for record on the 1st day of October, 1975 at 3:00 o'clock P.M.

*Tomie Bergey Fischer*  
 (Register of Deeds)

By: Deputy