

CERTIFIED LAND CORNER RESTORATION

Index No. **X-10**


State of Wisconsin

County of Oneida } ss.

I Philip T. Hansen, do hereby certify that on the 14th day of April, 19 75, I found evidence of the WC-1/16 corner of Section 33 Township 37, North, Range 11 East, Fourth Principal Meridian,

as described hereon; and that from this evidence I established a new monument and accessories as described hereon to perpetuate the original location of this corner.

Resident witnesses:

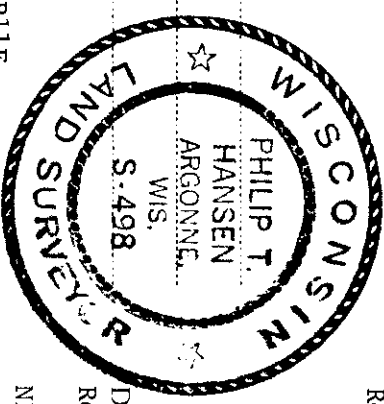


History of original corner establishment:  
 Corner established by H.C. Lawrence, Registered Land Surveyor, in 1958 during his retracement and subdivision survey. He commenced at the recovered original quarter corner between Sections 33 and 34, ran S89°00'W on random line, and intersected N-S random line at 38.19 chains North of S-1/4 corner. Intersect N-S line between Sections 32 and 33, 7 links North of 1/4 corner. Set C-1/4 corner 3 links South at 38.16 chains North. Set 4" cedar post at 22.06 equidistant East of W-1/4 corner and 4 1/2 links South of random line from which a white pine stump 20" bears N35°W, 13 links.

Description of corner evidence found:  
 Recovered 4" cedar post squared and scribed WC-1/16 S33, WC-1/16 S33 in poor condition. Rock carron had been placed around stake.  
 Recovered 0BT white pine stump scribed B0 at N31°W, 14 links instead of N35°W, 13 links.

Description of monument and accessories I established to perpetuate the original location of this corner.  
 Replaced wooden stake with 1 1/2" OD iron pipe with 2" brass cap stamped -

NBT's - Cedar 19"      S56°W      99.8 links      scribed 1/16 BT      S498  
 Red maple 8"      N63°E      107.7 links      scribed 1/16 BT      T37N, R11E

WC-1/16      S33  
 CPT-1975

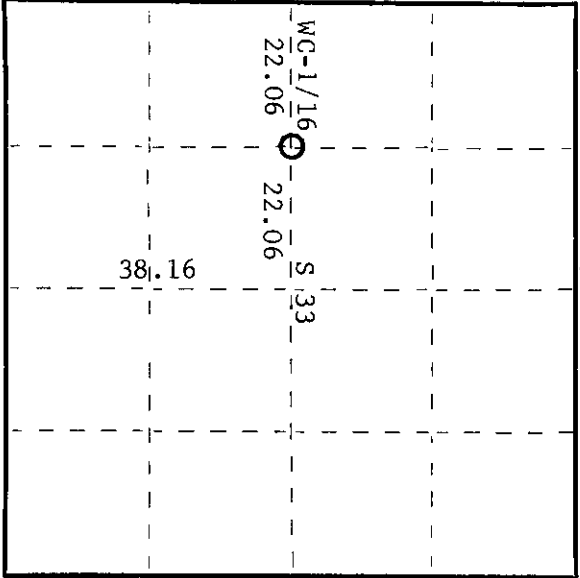

Dated at Rhineland, Wis., this 14th day of April, 19 75.

Signature Philip T. Hansen Title Registered Land Surveyor Registration No. S-498  
 County Surveyor, Registered Land Surveyor, or other duly authorized official

Office of Register of Deeds, County of Oneida  
 Instrument was filed in this office for record on the 1st day of October, 19 75  
 at 3:00 o'clock P. M.

Donna DeGeorge Tucker  
 Register of Deeds

By: \_\_\_\_\_ Deputy

3711332030