

CERTIFIED LAND CORNER RESTORATION



W 10 Index No. 24-10

State of Wisconsin

County of Oneida } ss.

I, Philip T. Hansen, do hereby certify that on the 14th day of April, 1975, I found evidence of the NW-1/16 corner of the Section 33 Township 37 North, Range 11 East, Fourth Principal Meridian, as described hereon; and that from this evidence I established a new monument and accessories as described hereon to perpetuate the original location of this corner.

Resident witnesses:

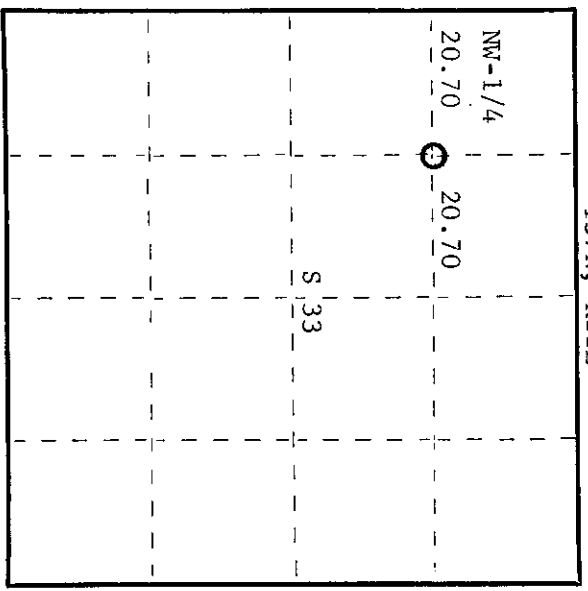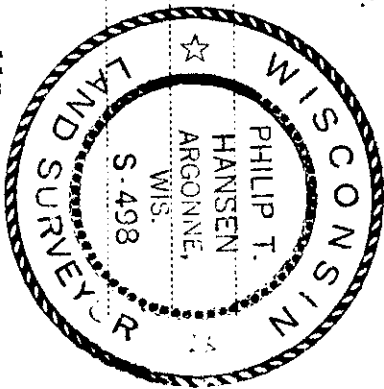

History of original corner establishment:

Corner established by H.C. Lawrence, Registered Land Surveyor, during his retracement and subdivision survey in 1958. From his established NC-1/16 corner he ran S89°00'1W on random line, 41.40 chains, intersected line between Sections 32 and 33, 1.75 chains South of Maine's N-1/16 corner. Set 6" cedar post 87 1/2 North of 20.70 chains from which cedar 10" bears West 14 links and black ash 5" bears S48°E, 16 links.

Description of corner evidence found:

Recovered 6" cedar post, squared and scribed NW-1/16 S33; NW-1/16 S33, in good condition. Recovered ORT's cedar 10" West, 14.8 links, scribed NW-1/16 BT and black ash 5" (now 6"), S48°E, 16 links, scribing grown over.

Description of monument and accessories I established to perpetuate the original location of this corner.

Replaced 6" post with 1 1/2" OD galvanized iron pipe with brass cap stamped -

S498 T37N, R11E

NW-1/4 S 33

CPT-1975

Dated at Rhinelander, Wis., this 28th day of April, 1975.

Signature Philip T. Hansen Title Registered Land Surveyor Registration No. S-498 (County Surveyor, Registered Land Surveyor, or other duly authorized official)

Office of Register of Deeds, County of Oneida I hereby certify that the within instrument was filed in this office for record on the 1st day of October, 1975 at 3:00 o'clock P. M.

Donna Verage Tushnet (Register of Deeds)

By: Deputy

371/323030

O = Corner monument restored.