



CERTIFIED LAND CORNER RESTORATION

Index No. **A-17**

State of Wisconsin }
 County of Oneida } ss.

I Phillip T. Hansen, do hereby certify that on the 2nd day of January, 1975, I found evidence of the Section corner of 2-3-34-35 Township, 36-37 North, Range 11 East, Fourth Principal Meridian, as described hereon; and that from this evidence I established a new monument and accessories as described hereon to perpetuate the original location of this corner.

Resident witnesses.

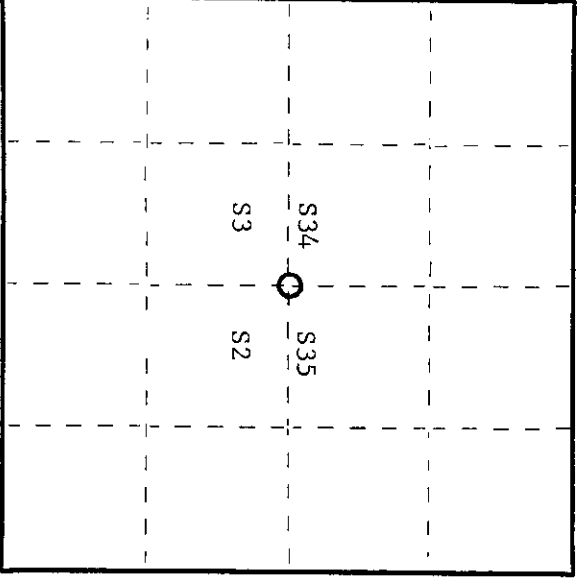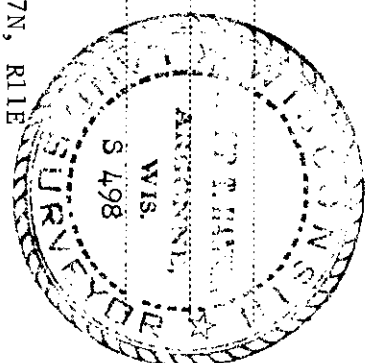

○ = Corner monument restored.

History of original corner establishment:
 Original corner established by H.C. Fellows, Gov't Deputy Surveyor in 1858.

Surveyed by J.J. Melendy in 1916. He recovered original BT's and set two new BT's.
 Tamarack 10" N40E 13 lks.
 Tamarack 8" S61W 17 lks.
 Pine 18" N39E 33 lks.
 Y. Birch 6" N69W 19 lks.
 Pine 14" S72½E 48 lks.

H.C. Lawrence retracement survey of 1950. He states that he recovered stumps of original tamarack BT's. Pine 18" was blown down, marks visible, Y. birch 6" still standing and stump of Pine 14" with marks visible remains. Set new post. No mention of NBT's.
 Description of corner evidence found:

Recovered old post in poor condition.
 Recovered H.C. Lawrence's 4" cedar post, squared and scribed S2-T36N; Sec. 35, T37N, S34, R11E, S3 in fair condition.
 Recovered old BT cedar 11 N24°W 34 lks. scribed T37N, R11E, S34 NBT.

Description of monument and accessories I established to perpetuate the original location of this corner.
 Set new 2-1/2" x 5' galvanized iron pipe with brass cap stamped -

NBT Sugar maple 14" S32°W 50½ lks. scribed S3 BT T37N, R11E S498

S34	S35
S3	S2

Dated at Rhineland, Wis., this 16th day of June, 1975.

Signature *Phillip T. Hansen* Title Registered Land Surveyor Registration No. S-498
 (County Surveyor, Registered Land Surveyor, or other duly authorized official)

Office of Register of Deeds, County of Oneida
 Instrument was filed in this office for record on the 1st day of October, 1975 at 3:00 o'clock P.M.

James Verage Kuehn
 (Register of Deeds)

By: Deputy

3711340000