

CERTIFIED LAND CORNER RESTORATION

Index No. **X-16**

State of Wisconsin


County of Oneida } ss.

I Philip T. Hansen, do hereby certify that on the 4th day of September, 1975, I found evidence of the EC-1/16 corner of Section 34, Township 37, North, Range 11 East, Fourth Principal Meridian, as described hereon; and that from this evidence I established a new monument and accessories as described hereon to perpetuate the original location of this corner.


Resident witnesses:

Glen Barker

Jim Claffin

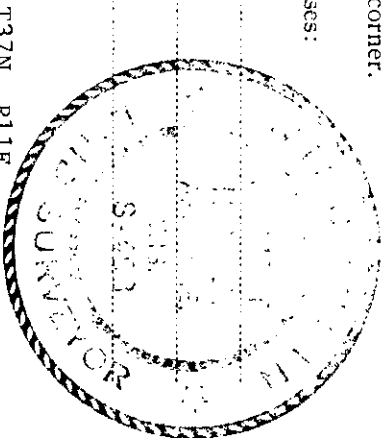

T37N, R11E

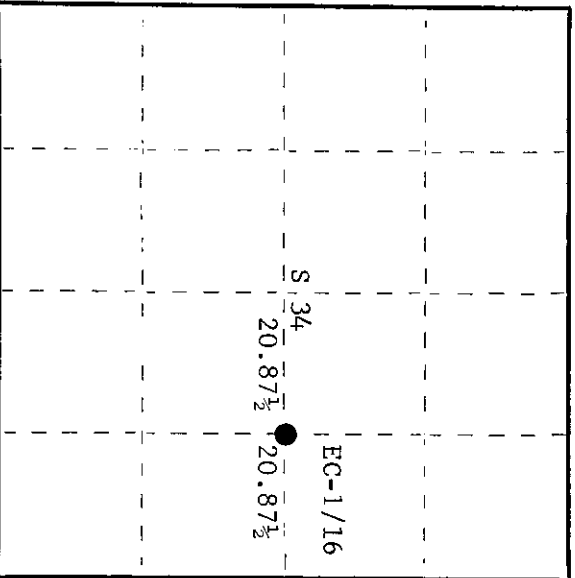

○ = Corner monument restored.

History of original corner establishment:

Corner established by H.C. Lawrence, Registered Land Surveyor, in 1952. He ran the E-W-1/4 line West from 1/4 between Sections 34 and 35 set by J.J. Melendy, Gagen Lumber Company Surveyor, in 1916. At 84.75 chains, intersected the West line at a point 20 links South of 1/4 corner at right angles. Intersected the corrected N-S-1/4 line at 41.75 chains West. Set the EC-1/16 corner at 20.87 1/2 chains West of East-1/4 corner equidistant and set hemlock 10", N78 1/2° W, 30 links and sugar maple 9", S48° W, 44 links.

Description of corner evidence found:

Recovered a 4" cedar post, squared and scribed S34, EC-1/16 S34, in fair condition. Recovered hemlock 10" (11"), N78° 30' W (N75° W), 30 links, scribed EC-1/16 and sugar maple 9" (10"), S48° W, 44 links (43 links), top scribing grown over, bottom scribed BT.

Description of monument and accessories I established to perpetuate the original location of this corner.

S498
T37N, R11E

Replaced cedar post with 1 1/2" OD iron pipe with 2" brass cap stamped -

No additional accessories established.

EC-1/16 S 34

CPI-1975

Dated at Rhineland, Wis., this 18th day of September, 1975.

Signature Philip T. Hansen Title Registered Land Surveyor Registration No. S-498
(County Surveyor, Registered Land Surveyor, or other duly authorized official)

Office of Register of Deeds, County of Oneida
Instrument was filed in this office for record on the 17th day of November, 1975
at 10:00 o'clock A. M. I hereby certify that the within

By Doris Terape Kuehn (Register of Deeds)

By _____ Deputy

3711342010

CERTIFIED LAND CORNER RESTORATION

Index No. X-116

State of Wisconsin

County of Oneida } ss.

I, Phillip T. Hansen, do hereby certify that on the 4th day of September, 1975, I found evidence of the EC 1/16 corner of Section 34 Township 37, North, Range 11 East, Fourth Principal Meridian, as described hereon; and that from this evidence I established a new monument and accessories as described hereon to perpetuate the original location of this corner.

Resident witnesses:

Glen Barker

Jim Claflin

History of original corner establishment:


Description of corner evidence found:


Recovered 4" cedar post, squared and scribed S34 EC 1/16, S34 EC 1/16, in fair condition. Recovered CRT's - Hemlock 10" (11") N78°30'W (N75°W) 30 links (29 links) scribed EC 1/16. Super 9" (10") S48°W 44 links (43 links), bottom scribed BT.

Description of monument and accessories I established to perpetuate the original location of this corner. Replaced 4" cedar post with 1-1/2" iron pipe with 2" brass cap, stamped: Monument projects 18". No additional accessories established.

T37N R11E

EC 1/16 S 34

CTI-S498

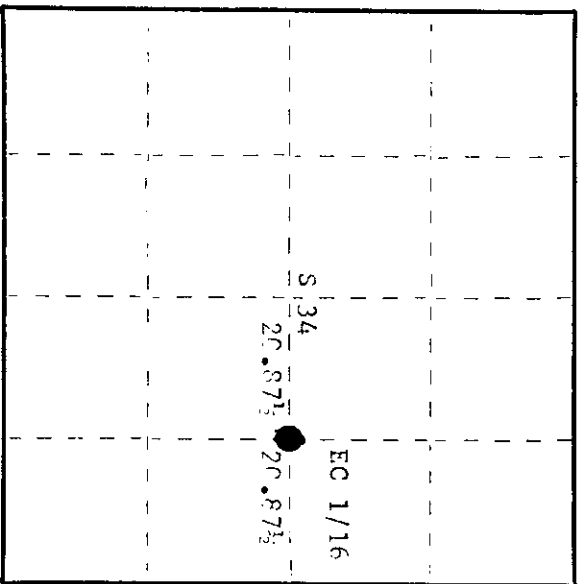

○ = Corner monument restored.

Dated at Rhineland, Wis., this 26th day of November, 1979.

Signature Phillip T. Hansen Title Registered Land Surveyor Registration No. S-498
(County Surveyor, Registered Land Surveyor, or other duly authorized official)

Office of Register of Deeds, County of Oneida I hereby certify that the within instrument was filed in this office for record on the 3rd day of December, 1979 at 11:5 o'clock PM.

Terrie Verage Tuelken
(Register of Deeds)

By: _____ Deputy

3711342010