

CERTIFIED LAND CORNER RESTORATION

Index No. **X-15**

State of Wisconsin

County of Oneida } ss.



I Phillip T. Hansen, do hereby certify that on the 31st day of October, 1975, I found evidence of the C-1/4 corner of Section 34 Township 37, North, Range 11 East, Fourth Principal Meridian, as described hereon; and that from this evidence I established a new monument and accessories as described hereon to perpetuate the original location of this corner.

Resident witnesses:

Glen Barker

Jim Claflin

T37N, R11E

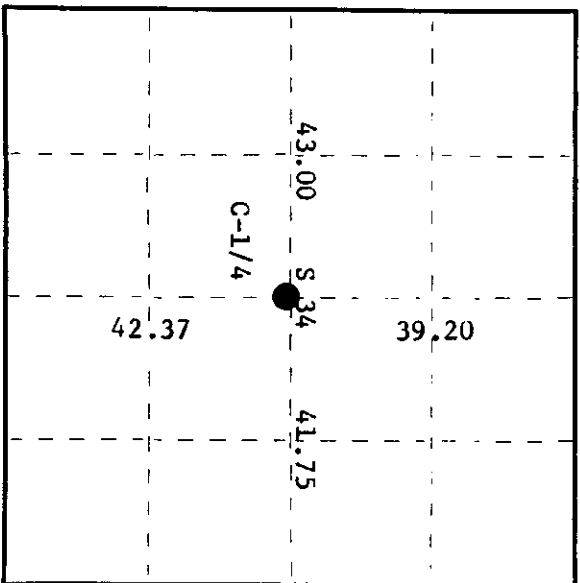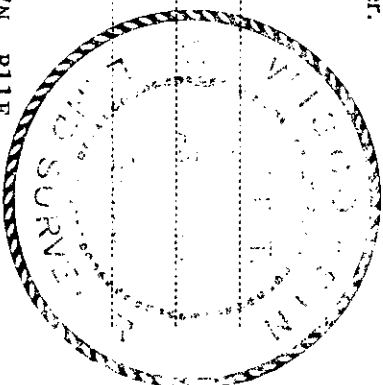

○ = Corner monument restored.

CERTIFIED LAND CORNER RESTORATION

History of original corner establishment:

Corner established by H.C. Lawrence, Registered Land Surveyor, in 1952. He ran the N-S 1/4 line south 0°55'E from N-1/4 corner to S-1/4 corner and the E-W 1/4 line N88°40'W from the E-1/4 corner to the west 1/4 corner. Corrected lines and set 5" cedar post at C-1/4 corner. Marked NBT's - Cedar 9" S170E, 18 links and cedar 9" S30°W, 25-1/2 links.


Description of corner evidence found:

Recovered 5" cedar post, squared and scribed C-1/4S S34, C-1/4S S34.

Recovered OBT's - Cedar 9" (10") S170E 18 links (25.5) Scribed C-1/4S 34 BT
Cedar 9" S30°W 25.5 (17.5) Scribed C-1/4 BT

Lawrence had the distance to his BT's reversed.

Description of monument and accessories I established to perpetuate the original location of this corner.
Replaced 5" cedar post with 2-1/2" iron pipe with brass cap stamped - S498
No additional accessories established. T37N R11E
Pipe and BT's painted blue. CPI-1975

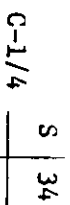

Dated at Rhineland Wis. this 7th day of November, 1975

Signature Phillip T. Hansen Title Registered Land Surveyor Registration No. S-498
(County Surveyor, Registered Land Surveyor, or other duly authorized official)

Office of Register of Deeds, County of Oneida I hereby certify that the within instrument was filed in this office for record on the 9th day of November, 1976 at 1:30 o'clock P. M.

Lorice Berge Kuehn
(Register of Deeds)

By: _____ Deputy

3711342020