

CERTIFIED LAND CORNER RESTORATION

Index No. W-16

State of Wisconsin

County of Oneida } ss.

I Phillip T. Hansen

do hereby certify that on the 3rd day

of November, 1975, I found

evidence of the NE-1/16

corner of Section 34

Township 37, North, Range


11 East, Fourth Principal Meridian,

as described hereon; and that from this evidence I established a new monument and accessories as described hereon to perpetuate the original location of this corner.


Resident witnesses:

Glen Barker

Jim Claflin

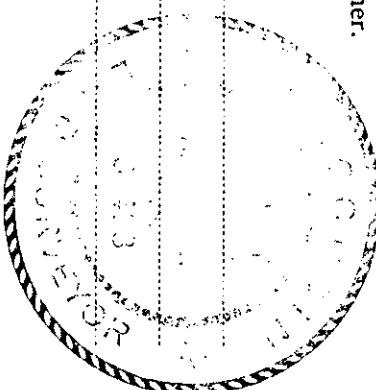

T37N, R11E

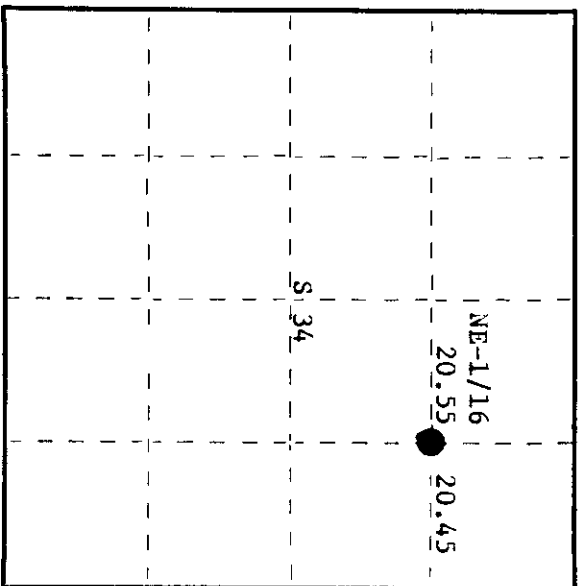

○ = Corner monument restored.

History of original corner establishment:

Corner established by H.C. Lawrence, Registered Land Surveyor, in 1952. He ran a random line north from EC-1/16 corner to E-1/16, distance 39.36 chains. Corrected bearing N1°30'W. Then ran east from NC-1/16 a distance of 41.00 chains to point 20 links north of N-1/16 between Sections 34 and 35. Set NE-1/16 at 20.55 chains east of NC-1/16 corner. Marked NBT's - Tamarack 5" N75°E, 21-1/2 links and spruce 12" S13°E, 43 links.

Description of corner evidence found:

Recovered 4" cedar post, squared and scribed NE-1/16 S34, NE-1/16 in poor condition.

Recovered 0BT's - Spruce 12" S13°E 43 links Now a cut-off stump.
Tamarack 5" (8") N75°E (N79°E) 21.5 links Scribed NE-1/16 BT.

Description of monument and accessories I established to perpetuate the original location of this corner.

Replaced 4" cedar post with 1" OD iron pipe with 2" brass cap stamped - S498

NBT - W. birch 10" S26°W 77 links Scribed 1/16 BT T37N R11E

Pipe projects 18" above ground. NE-1/16 S 34

Pipe and BT's painted blue.

CPI-1975

Dated at Rhinelander, Wis., this 10th day of November, 1975.

Signature Phillip T. Hansen Title Registered Land Surveyor Registration No. S-498
(County Surveyor, Registered Land Surveyor, or other duly authorized official)

Office of Register of Deeds, County of Oneida. I hereby certify that the within instrument was filed in this office for record on the 9th day of November, 1976 at 1:30 o'clock P. M.

Rona LePage Kuehn
(Register of Deeds)

By Phillip T. Hansen Deputy

371134 3010