



CERTIFIED LAND CORNER RESTORATION

Index No. A-21

State of Wisconsin }
 County of Oneida } ss.

I Phillip T. Hansen, do hereby certify that on the 10th day of December, 19 74, I found evidence of the Section corner of 1-2-35-36 Township 36 and 37 North, Range 11 East, Fourth Principal Meridian, as described hereon; and that from this evidence I established a new monument and accessories as described hereon to perpetuate the original location of this corner.

Resident witnesses.

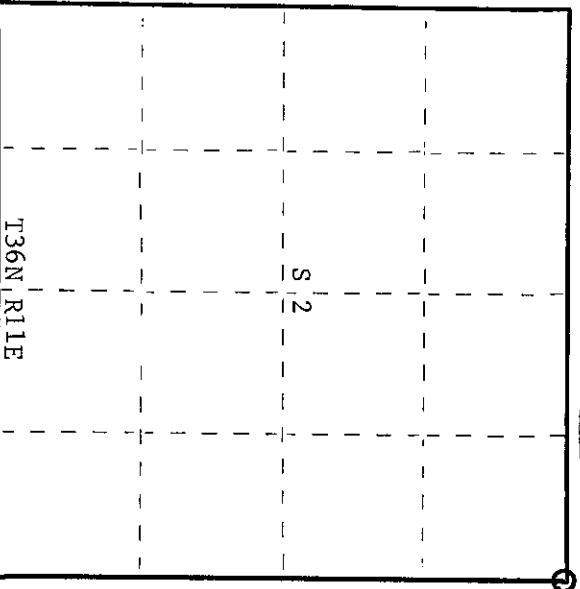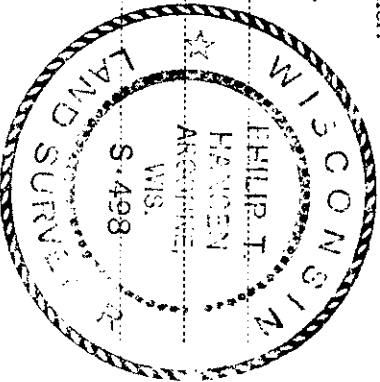

O = Corner monument restored.

History of original corner establishment:
 Original survey established by Wm. E. Dougherty in 1859.

Spruce 8"	N49W	22 links
Spruce 8"	N53E	20 links
Spruce 6"	S48E	10 links
Spruce 6"	S62W	8 links

Retracement survey made by H.C. Lawrence in 1957. He states he recovered two old wooden stakes and a 2" iron pipe. No record of BT's noted. He set a new 4" tamarack stake blazed and scribed S1 S2, S35 and S36. Blazed and scribed a 6" tamarack, S72W, 145 links.

Description of corner evidence found:
 Recovered two old wooden stakes, 4" tamarack squared and scribed S1, S2, S35, and S36 in fair condition and a 2" iron pipe. Recovered old bearing tree, 6" tamarack, S72W, 145 links, in good condition. No traces of other old BT's.

Description of monument and accessories I established to perpetuate the original location of this corner.
 Set 2-1/2" x 5' galvanized iron pipe with brass cap stamped -

Blazed and scribed new bearing trees - Black spruce 4" N42W 20 1/2 links T37N, R11E
 Black spruce 6" S18E 35 links S498

S35	S36
S2	S1

T36N, R11E
 CPT-1974

Dated at Rhineland, Wis., this 10th day of December, 19 74.

Signature Phillip T. Hansen Title Registered Land Surveyor Registration No. S-498
 (County Surveyor, Registered Land Surveyor, or other duly authorized official)

Office of Register of Deeds, County of Oneida.
 Instrument was filed in this office for record on the 10th day of October 19 75 at 300 o'clock P. M. hereby certify that the within

Doris Berge Tuck
 (Register of Deeds)

By: _____ Deputy

00005M11E