



CERTIFIED LAND CORNER RESTORATION

Index No. A-20

State of Wisconsin }
 County of Oneida } ss.

I, Phillip T. Hansen, do hereby certify that on the 31st day of December, 1974, I found evidence of the E-1/16 corner of Sections 35 and 2 Township 37-36 North, Range 11 East, Fourth Principal Meridian, as described hereon; and that from this evidence I established a new monument and accessories as described hereon to perpetuate the original location of this corner.

Resident witnesses:

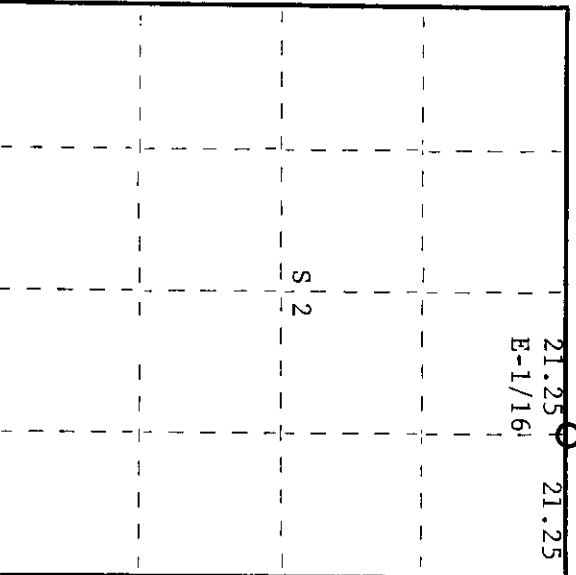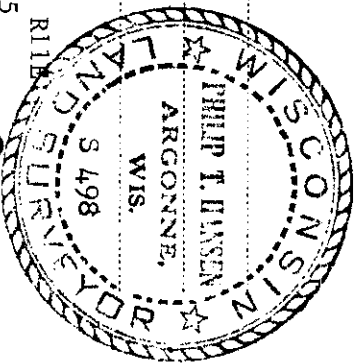

○ = Corner monument restored.

History of original corner establishment:
 Original corner established by V.M. Maine, County Surveyor about 1935.

BT White pine 18" West 22 lks.
 Spruce 6" N20E 12 lks.

H.C. Lawrence, Reg. Land Surveyor retracement survey, 1950. Set new corner post and new BT. Spruce 8" N88°E 19 lks. He ran a random line from 1/4 between Sec. 35, 37-11 and Sec. 2, 36-11 East with vernier adjusted to 104.5' E var. a distance of 42.50 chains which intersected his N-S line between Sections 1 and 2, 2.45 chains South of the corner. E-1/16 Corner corrected and checked with V.M. Maine's corner in correct position. Bearing of true line N84°58'E.

Description of corner evidence found:
 Recovered H.C. Lawrence's 5" cedar post, squared and scribed S2 E1/16 S35 E-1/16 in fair condition. Maine's 4" cedar post, squared and scribed S2 E-1/16; S35 E-1/16 also recovered in poor condition. Recovered Maine's BT white pine 18", West, 22 lks. dead but sound. Scribed 1/8 BT.
 No other BT's visible.

Description of monument and accessories I established to perpetuate the original location of this corner.

Set 1" x 5' galvanized iron pipe with 2" brass cap stamped -

New BT	Black spruce 9"	N45E	44 lks.	scribed 1/16 BT	S 35
	Black spruce 7"	S23W	11-3/4 lks.	scribed 1/16 BT	R 11 E

S 35
 R 11 E
 E-1/16
 S 2
 T36N
 CPT-1974

Dated at Rhineland, Wis., this 10th day of June, 1975.

Signature *Philip T. Hansen* Title Registered Land Surveyor Registration No. S-498
 (County Surveyor, Registered Land Surveyor, or other duly authorized official)

Office of Registrar of Deeds, County of Oneida, Wis. I hereby certify that the within instrument was filed in this office for record on the 1st day of October, 1975 at 3:00 o'clock P.M.

Doris Verage Kuehn
 (Registrar of Deeds)

By _____ Deputy

3711350010