

CERTIFIED LAND CORNER RESTORATION


Index No. **Y-18**
 Y 18

State of Wisconsin

County of Oneida } ss.

I, Philip T. Hansen, do hereby certify that on the 6th day of January, 1975, I found evidence of the SW-1/16 corner of Sec. 35 Township 37 North, Range 11 East, Fourth Principal Meridian, as described hereon; and that from this evidence I established a new monument and accessories as described hereon to perpetuate the original location of this corner.

Resident witnesses:

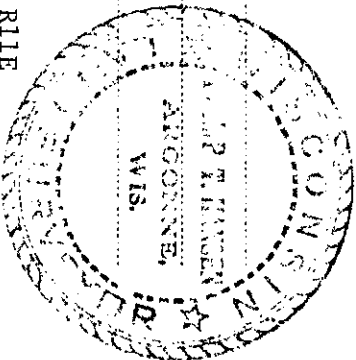

T37N, R11E

History of original corner establishment:
 Corner established by H.C. Lawrence, Reg. Land Surveyor during his retracement survey in 1949. He states that he ran South 2°30'E mag. from the W C-1/16 Corner 38.92 chains to intersect the town line 66 lks. East of the W-1/16 Corner. Corrected true bearing of line S1°32'E. From the S-1/16 Corner between S34 and 35 he ran N89°30'E mag. 42.20 chains to intersect the N-S. Corrected 1/4 line 2.36 chains South of the SC-1/16 Corner. Bearing of corrected line N86°18'E. Set a 4" cedar post.

Description of corner evidence found:
 Recovered 4" cedar post, squared and scribed S35 SW-1/16 S35 in poor condition.
 Recovered old bearing tree.


BT's	Yellow birch 10"	N48W	47 lks.
	Elm 12"	N55E	57 lks.
	Yellow birch 10"	N48W	47 lks.
	Elm 12"	N55E	57 lks.

Description of monument and accessories I established to perpetuate the original location of this corner.

Set new 1" x 5' galvanized iron pipe with 2" brass cap stamped -

New BT's Sugar maple 10" S64°W 38½ lks. scribed 1/16 BT T37N, R11E S498

SW-1/16 S35
 CPI-1975

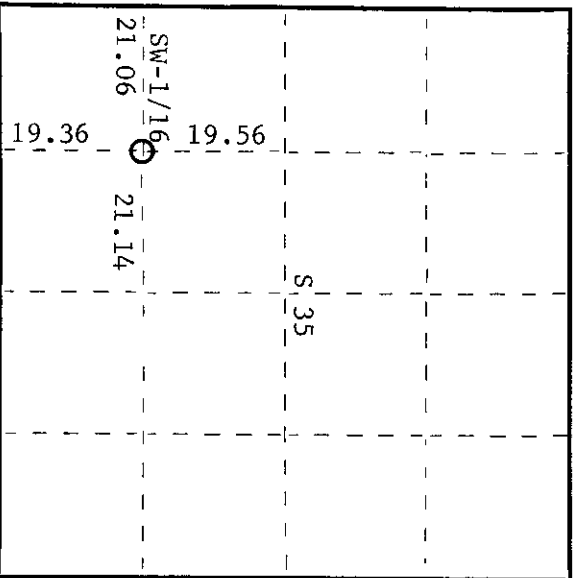

○ = Corner monument restored.

Dated at Rhinelander, Wis., this _____ day of _____, 19____

Signature: *Philip T. Hansen* Title: Registered Land Surveyor Registration No. S-498
 (County Surveyor, Registered Land Surveyor, or other duly authorized official)

Office of Register of Deeds, County of _____ at _____ day of _____, 1975
 at 3:00 o'clock P. M. I hereby certify that the within instrument was filed in this office for record on the _____ day of _____, 1975

Doris Verage Fuchs
 (Register of Deeds)

By _____ Deputy

3711351030