


CERTIFIED LAND CORNER RESTORATION

Index No. **X-220**


X 20

State of Wisconsin }  
County of Oneida } ss.

I Philip T. Hansen, do hereby certify that on the 27th day of May 1975, I found evidence of the EC-1/16 corner of Section 35 Township 37 North, Range 11 East, Fourth Principal Meridian, as described hereon; and that from this evidence I established a new monument and accessories as described hereon to perpetuate the original location of this corner.

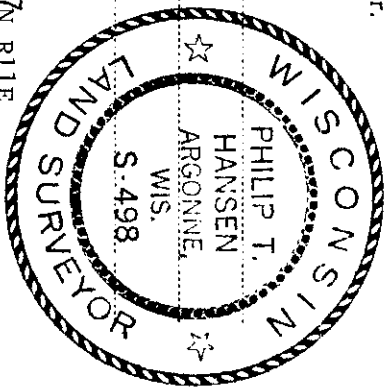

Resident witnesses:

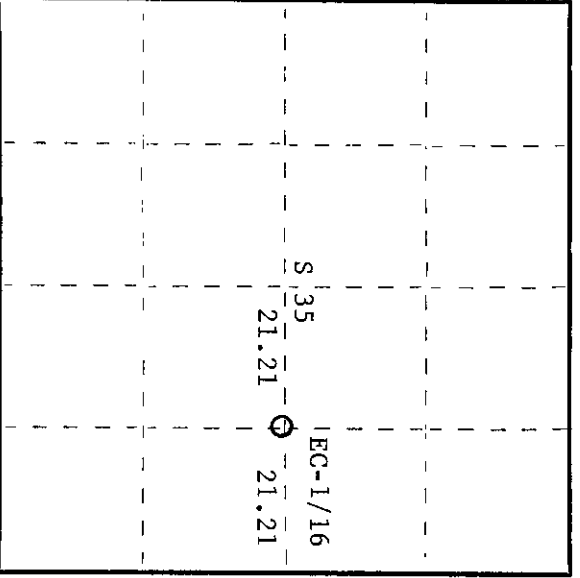

○ = Corner monument restored.

History of original corner establishment:

Corner established by H.C. Lawrence, Registered Land Surveyor, during his retracement and subdivision survey of 1949. From restored W½ corner, set by J.A. Melendy in 1916, ran east-west ½ line N88°30'E 84.60 chains to intersect line between Section 35 and 36 24 links north of ¼ corner. Corrected bearing to N88°40'E. Set ¼ corner 42.18 chains east of W½ corner, 42.42 chains west of east ¼ corner. Set EC-1/16 corner post, 4" cedar, 20 links south of 63.39, east or 21.21 chains equidistant between ¼ corner and E½ corner, from which yellow birch 18" bears S50°W 34½ links and sugar 16" bears S32°E 22 links.

Description of corner evidence found:

Recovered 4" cedar post, squared and scribed EC-1/16 S35, EC-1/16 S35, in poor condition.  
Recovered 0BT's - yellow birch 18" S50°W 34.5 links, now a 5" stub, scribed EC-1/16 S35 BT. Sugar 16" S32°E 22 links, decayed stump. No scribe marks visible.

Description of monument and accessories I established to perpetuate the original location of this corner.

Replaced 4" cedar post with 1½" O.D. iron pipe with 2" brass cap stamped - S498  
NBT's - elm 7" S40E 23.4 links, scribed 1/16 BT. T37N R11E  
Basswood 10" N62°W 41.5 links, scribed 1/16 BT.

EC-1/16 S 35  
CPI-1975

Dated at Rhineland, Wis., this 11th day of June, 1975.

Signature: *Philip T. Hansen* Title: Registered Land Surveyor Registration No. S-498  
(County Surveyor, Registered Land Surveyor, or other duly authorized official)

Office of Register of Deeds, County of Oneida  
Instrument was filed in this office for record on the 1st day of October, 1975 at 3:00 o'clock P.M.

*Terrie Verage Fisher*  
Register of Deeds

By: Deputy

3711352010