
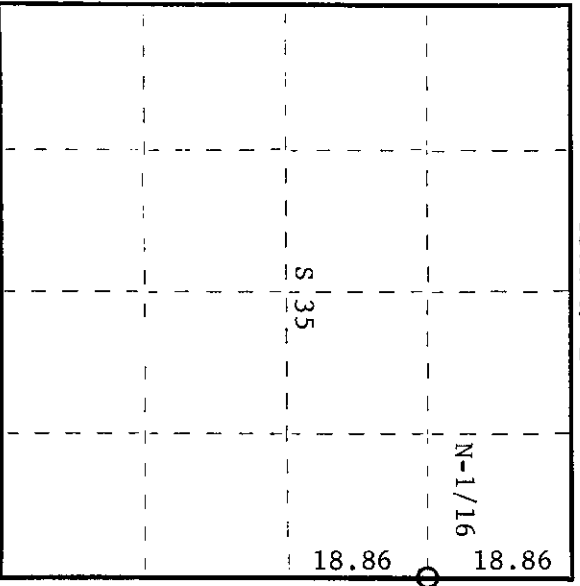


CERTIFIED LAND CORNER RESTORATION

Index No. 2K-21  
W 21

State of Wisconsin } ss.  
County of Oneida

I Philip T. Hansen, do hereby certify that on the 27th day of May, 1975, I found evidence of the N-1/16 corner of Sections 35 and 36 Township 37 North, Range 11 East, Fourth Principal Meridian, as described hereon; and that from this evidence I established a new monument and accessories as described hereon to perpetuate the original location of this corner.

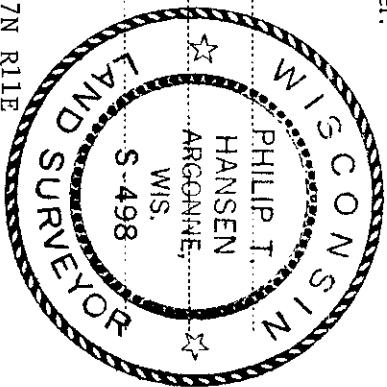

○ = Corner monument restored.

History of original corner establishment:  
Corner established by J.A. Melendy in 1916, when he ran south from NE corner to SE corner. Set corner from which hemlock 14" bears N81°E 26½ links, and basswood 8" bears N4°W 7½ links.  
V.M. Maine, County Surveyor, recovered this corner in 1935. Established NBT's - maple 10" N35°W 49 links, and elm 12" N29°E 34 links.  
H.C. Lawrence, Registered Land Surveyor, recovered Melendy's corner in 1949. Set a new 6" cedar post in hole of his old post. His chainage of distance from NE corner to N-1/16 post differs from Melendy's by 0.12 chain.

Description of corner evidence found:  
Recovered H.C. Lawrence's 6" cedar post, squared and scribed N-1/16 S35, N-1/16 S36, in fair condition. Someone had placed a 1½" iron pipe beside it.  
Recovered OBT's - maple 10" N35°W 49 links, now a decayed stump.  
Hemlock 14" N81°E 26.5 links, blown over and decayed. Piece of scribing still visible.  
Elm 12"(15) N29°E 34 links, scribing grown over.

Description of monument and accessories I established to perpetuate the original location of this corner.  
Replaced wooden stake with 1½" O.D. iron pipe with 2" brass cap stamped -  
S498  
NBT - sugar 7" S51°W 27.6 links, scribed N-1/16 BT.  
T37N R11E

N-1/16 S35 | S36  
CPI-1975

Dated at Rhineland, Wis., this 12th day of June, 1975

Signature Philip T. Hansen Title Registered Land Surveyor Registration No. S-498  
(County Surveyor, Registered Land Surveyor, or other duly authorized official)  
Office of Register of Deeds, County of Oneida  
Instrument was filed in this office for record on the 1st day of October, 1975 at 3:00 o'clock P.M.

Signature Torrie Vantage Tuelker  
(Register of Deeds)

By \_\_\_\_\_ Deputy

00035113300