

REGISTER OF DEEDS OFFICE  
Received for Record

APR 25 1969

AT 2:30 O'CLOCK P.M. DULY RECORDED IN  
VOL. 18 OF RECORDS ON PAGE 167

RG-5680-B (7/15/64) W. C. MILLER CO., MILWAUKEE 448643

CERTIFIED LAND CORNER RESTORATION

REGISTER OF DEEDS

180727

State of Wisconsin }  
County of Price } ss.

I Elwood L. Olson, do hereby certify that on the 18th day of April, 1968, I found evidence of the One Quarter corner of Sections 1 and 6 Township 38 North, Range 3 and 4 East, Fourth Principal Meridian, as described hereon; and that from this evidence I established a new monument and accessories as described hereon to perpetuate the original location of this corner:

Description of original monument and accessories and subsequent restorations:

Original corner established in 1864 by Alex Anderson, Government Deputy Surveyor.  
Cedar 9 S10W, 8 links.  
Cedar 16 N67E, 8 links.


From 874-9 corner record by Harry L. Sykes, U.S. Forest Service, dated 1-6-1936:  
Corner marked by Cedar post (good condition) Line N.-S. cut out 4 feet wide.  
Original Cedar bearing tree down, N67°E, 12 links, blaze decayed, only 1/4 marks visible.  
Balsam 6", East, 10 feet (location poster)

Description of corner evidence found:


Corner marked by old 3 inch squared cedar post marked "1/4, S6, 1/4, S1" extending 30" above swamp level. Found Sykes location poster on a dead Balsam bearing N76°E, 9.7 feet from corner post. The post is on an old N.-S. cut out line and in a Cedar swamp. From corner, I measure 85 feet south to a 2 ft. wide creek (partly underground) which runs east.

Description of monument and accessories I established to perpetuate the original location of this corner:

In place of old post set 2" dia., 5' long, flanged bottom, concrete filled, galvanized wrought iron pipe, extending 12" above swamp level, with 3" bronze tablet on top stamped: T38N,R3E,R4E, 1/4, S1, S6, S.785, 1968.  
Blazed and scribed new bearing trees as follows:  
Cedar 10", N49°E, 14.9 feet.  
Cedar 8", S78°W, 28.8 feet.  
Cedar 8", N22°W, 48.1 feet.  
Iron sign post, South, 1.6 feet.

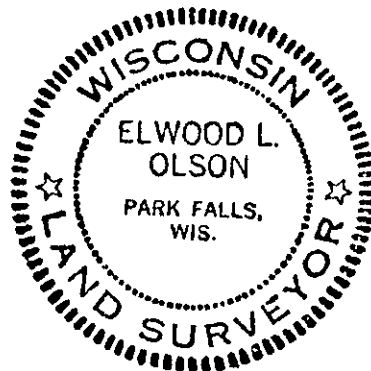

2803012000

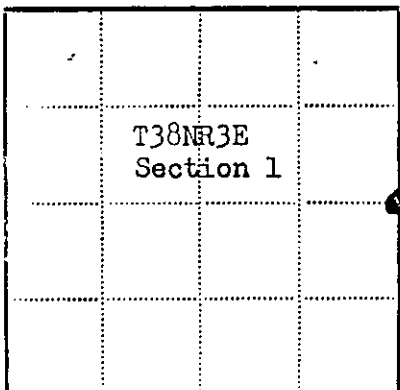

● - Corner monument restored  
□ -

Resident witnesses.....

Dated at Park Falls Wisconsin, this 14th day of February 1969.

Signature Elwood L. Olson Title Registered Land Surveyor  
(County Surveyor, Registered Land Surveyor, or other duly authorized official)

Surveyors Registration No. S-785

Office of..... County of.....

I hereby certify that the within instrument was filed in this office for record on the..... day of..... 19....., and was filed in Book No..... Page No..... of County Records.

Signature..... Title.....

Township....., Range....., Section....., Index No....., Page No.....