

CERTIFIED LAND CORNER RESTORATION

J-1  
 (38-4) 225  
 Index No. 1

History of original corner establishment:  
**Original corner established in 1864 by Alex Anderson, Government Deputy Surveyor.**

- Ironwood 7 N64W 33 11nks**
- Hemlock 10 N47E 20 11nks**
- Sugar 7 S37E 24 11nks**
- Birch 10 S20W 16 11nks**

State of Wisconsin

County of **Price** } ss.

I, **Elwood L. Olson**, do hereby certify that on the **9th** day of **January**, 19**64**, I found evidence of the **Section** corner of **Sections 7-12-13-18** Township **38**, North, Range **3** and **4 East**, Fourth Principal Meridian, as described hereon; and that from this evidence I established a new monument and accessories as described hereon to perpetuate the original location of this corner.


Resident witnesses:

Description of corner evidence found:

**Corner marked by old 4" squared cedar post scribed S7, S12, S13, S18. I found the following old bearing trees:**  
**Maple 16° N48°W, 19.0 feet.**  
**W. Ash 12° S23°E, 29.1 feet.**  
 Blazes on both trees almost grown over, scribe marks visible.  
**Alongside said cedar post, laying on ground, found remains of a very old wood post. Found location tag by Nekosoa Edwards Paper Co. on 8° W. Ash which brs. S34°E, 13.5 feet. Old lines run N., S. and E. from corner.**

Description of monument and accessories I established to perpetuate the original location of this corner.

**Set 2" inside dia., 5' long, flanged bottom, concrete filled, galvanized wrought iron pipe with 3" bronze tablet stamped: T38N, R3E, S7, S12, S13, S18, S.785, 1964. Monument set 16" above ground. Set red top cedar post 2.4 ft. N. of mon.**  
**Blazed and scribed new bearing trees as follows:**  
**Sugar Maple 15° S72°W, 35.8 feet, mkd. ⊗ BT S13 BT.**  
**W. Ash 7° N33°E, 11.2 feet, mkd. ⊗ BT S7 BT.**  
**Nail metal BT sign on all bearing trees. Paint BTs red.**  
**Chisled cross (+) on top of large rock 6.5' x 2.8' x 21" high, cross bears S17°30'W, 27.4 feet from monument.**

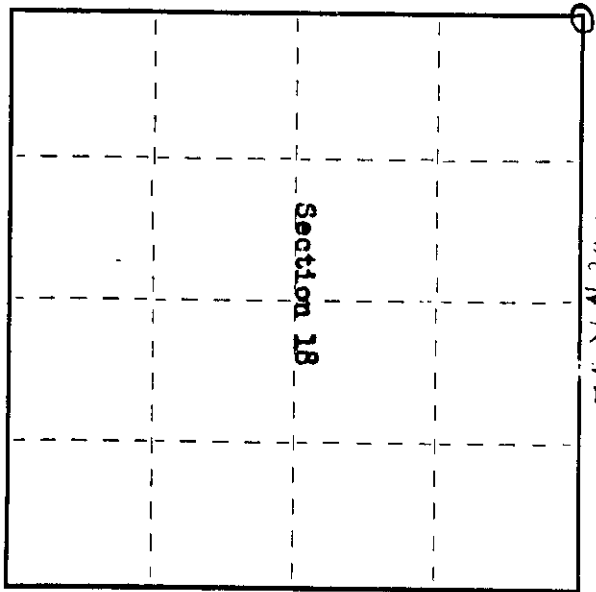

○ = Corner monument restored.

Dated at **Park Falls**, Wis., this **6th** day of **March**, 19 **64**

Signature: **Elwood L. Olson**, Title **Registered Land Surveyor**, Registration No. **S.785**  
 (County Surveyor, Registered Land Surveyor, or other duly authorized official)

Office of Register of Deeds, County of \_\_\_\_\_, Wis.,  
 instrument was filed in this office for record on the \_\_\_\_\_ day of \_\_\_\_\_, 19**64** at \_\_\_\_\_ o'clock \_\_\_\_\_ M.

By \_\_\_\_\_ Deputy

