

This form is intended to fulfill requirements of Chapter A-E 7.08 (3)(a) thru (i) U.S. Public Land Survey Monument Location Record, Wisconsin Administrative Code. Use reverse side for geodetic location data and/or other continuation purposes.

U.S. PUBLIC LAND SURVEY MONUMENT LOCATION RECORD

Recorders Data

USPLS CORNER: NW SECTION CORNER SECTION: 15 TOWNSHIP: 38 NORTH RANGE: 4 EAST

NAME OF WATERWAY FOR M.C. CORNER: N/A SECTION LINE: N/A

(CITY)(VILLAGE)(TOWN) OF: MINOCQUA COUNTY OF: ONEIDA

Description of monument found or placed and all other evidence used as the basis for monument location; including monuments and related measurements required if the corner location was reestablished by lost corner proportionate methods. Also indicate name of original surveyor, original survey date and the corner monument, bearing trees, witness or other reference monuments established; including measured bearing and distance ties, from available records.

Found and accepted an older faded blue painted 1.25" dia. iron pipe with unstamped water pipe cap about 30" above grade and loose in ground cavity. I carefully pulled the 50" long iron pipe and reset the corner location with a standard 2" dia. by 30" long aluminum pipe monument with stamped Oneida County cap 6" above grade of a small shallow ground depression on south edge of an unimproved woods roadway berm. The woods road leads West from Pine Lake Road located about 225' East of the corner location.

I also found an old decaying 4" dia. wood corner marker post with a squared top lying flat on grade near the corner monument and a newer 4.5" dia. wood post with flat cut top OK 10" S.E. of the corner. I left the older iron pipe monument flat on grade next to the corner.

Rotting white poly aerial photo panel material was also found in grassy ground surface at the corner location.


In April, 1865, Alexander Anderson/GLO set a wood post as original corner and marked OBTs: a 10" Maple N08°W 7 links and a 10" Pw S41°E 6 lks, which are all now obliterated.

This corner recovery is based solely upon information provided on section data sheets filed by William Stuth of O&I in Oneida County records for Section 15 dated 1987 and Section 16 dated 1989.

No other corner evidence was detected nor observed within a half chain radius of the corner monument found.

This recovery completed April 9, 1999; there were no witnesses.

Plan view map of monument location with bearing and distance ties to a minimum of four(4) described witness or reference monuments of concrete, natural stone, iron, live bearing trees or equivalent material. If applicable, also show a minimum of two(2) bearing and distance ties to any other monument found and not accepted; including the bearing and distance from the accepted monument.

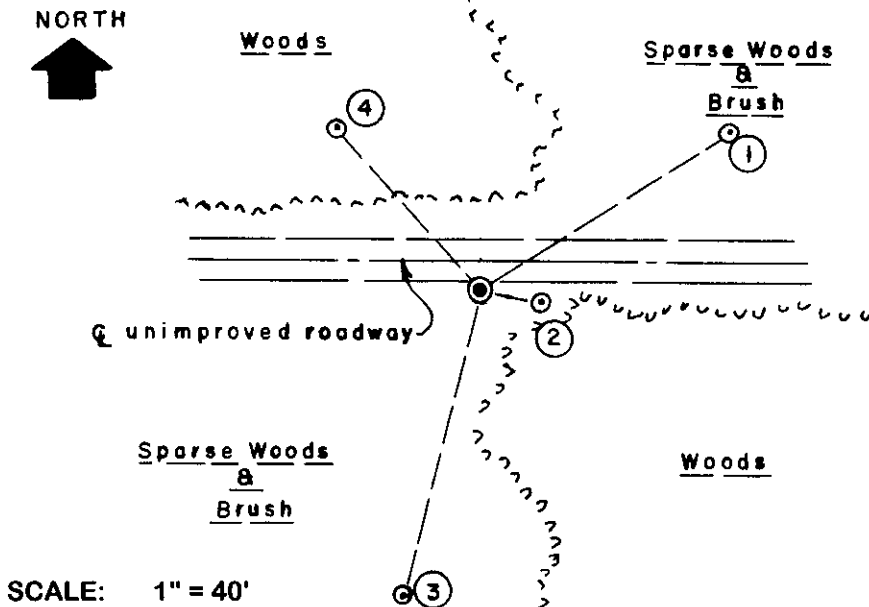

WITNESS MONUMENT TIES:

- ① New BT, 4.5" Pj N57°E 61.38'.
- ② New BT, 4" Pw S79°E 13.16'.
- ③ New BT, 5" Pw S14°W 67.34'.
- ④ New BT, 7" Pw N42°W 44.96'.

I set a standard white poly 'T' corner marker post 8" North of the corner monument on south berm of East/West unimproved woods roadway.

The corner is located about 11 feet South of the centerline of the foregoing woods roadway in a sparsely wooded area.

SCALE: 1" = 40'

Unless otherwise indicated, all bearing tree ties are to a .25" dia. by 2.5" long PK nail with a 1.25" dia. steel washer driven into unblazed right face and a .25" dia. by 2.5" long PK nail is also driven into unblazed face of bearing tree at DBH; the basis for measured bearings is by magnetic compass to nearest degree and all tie distances are measured horizontal by steel tape corrected to nearest 1/100th feet at standard temperature of 68 degrees Fahrenheit.

RLS SEAL:



LAND SURVEYOR CERTIFICATE:

I, William C. Rohde, hereby certify that I am duly licensed as a Professional Land Surveyor in the State of Wisconsin; that this USPLS monument location was determined by me and/or under my direct supervision and control; and that this U.S. Public Land Survey Monument Location Record is true and correct to the best of my knowledge and belief.

Signed: *William C. Rohde*
William C. Rohde RLS 841

