


U.S. PUBLIC LAND SURVEY MONUMENT RECORD

Note: This form is intended and designed to fulfill all requirements of Wisconsin Administrative Code, Chapter A-E 7.08 U.S. Land Survey Monument Record (3)(a)(b)(c)(d)(e)(f)(g)(h)(i). An additional sheet may be added if necessary to conform with said requirements.

(a) CORNER LOCATION: State Plane Coordinates
 Meander Corner of Sec. 10 X _____
 Township 38 North Y _____
 Range 4 East Datum Base _____
 Town Minocqua County of Oneida

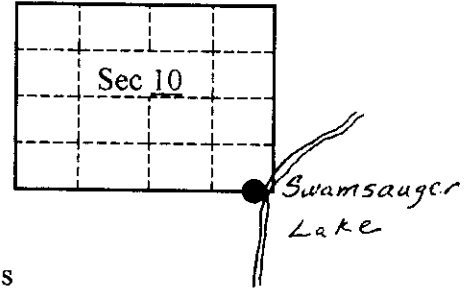


(b) HISTORY OF ORIGINAL CORNER ESTABLISHMENT Original B.T.'s
 Original Surveyor: Alex Anderson Fir 10", S79°W, 15 links
 Date of Survey: Commenced April, 1865 Hemlock 10", S2°E, 21 links
 Completed May, 1865

(b)(f)(g)(h) Description of monument found at this corner and if it was accepted, state all evidence (material, testimonial, occupational, plats, records, other monuments) used as a basis for accepting. If not accepted or if nothing was found, state evidence used as basis for establishing location. If reestablished through lost corner proportionate methods, indicate all monuments, distances and directions used to establish. Indicate type of monument and sign post found or set.

- 1865 - Alex Anderson set meander corner post.
- 1961 - Cameron (Northwoods Surveyors) survey map shows a NEPCO brass-capped monument with a 6" W. Birch B.T., S21°W, 29.2'.
- 1964 - Cameron (Northwoods Surveyors) shows a NEPCO brass-capped monument on the plat of "Swamsauger Heights" witnessed by a 2" iron pipe S85°35'W, 185.31'.
- 1997 - I found and accepted a 1 3/4" iron pipe with a 2" NEPCO brass cap witnessed by a 2 1/4" iron pipe S85°W, 184.44'.

(c)(d)(e) Plan view of corner with ties to at least 4 witness monuments. If in disagreement with previously established corner, show the distances between the two corners and also indicate the ties to the disputed.

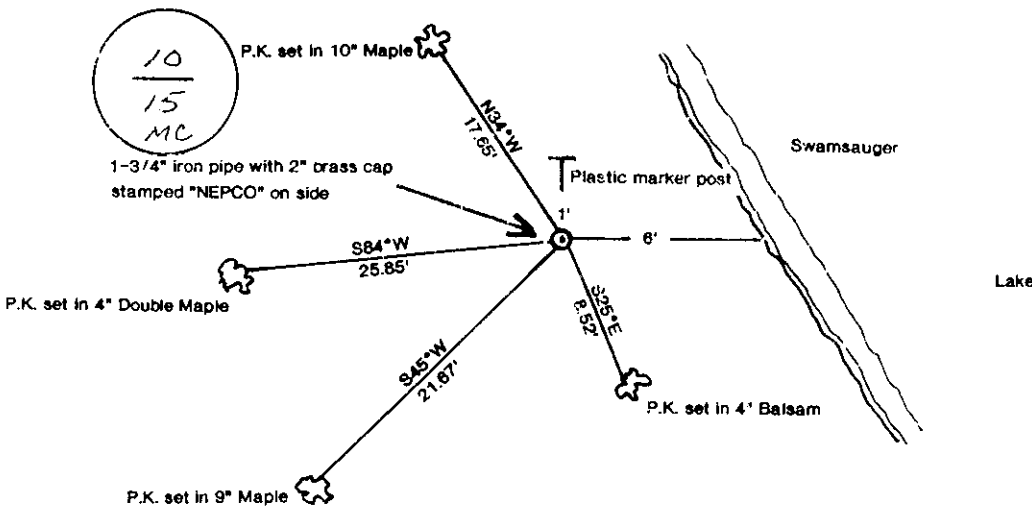

REGISTER OF DEEDS OFFICE
 ONEIDA COUNTY, WIS.
FILED
 JAN 18 1999
 At _____ O'Clock _____ PM
 THOMAS H. LEIGHTON
 REGISTER OF DEEDS

(i) I, Charles E. Winkler, #S-1431
 hereby certify that the corner location on this record was determined by me or under my direction and control and that this U.S. Public Land Survey Monument Record is correct and complete to the best of my knowledge and belief.

Charles E. Winkler 1/13/1999
 Signature Foltz & Associates, Inc. Date



3804 1000 03

Index No. 516-17