U.S. PUBLIC LAND SURVEY MONUMENT RECORD

Note: This form is intended and designed to fulfill all requirements of Wisconsin Administrative Code, Chapter A-E 5.02, U.S Public Land Survey Monument Record (3) (a) (b) (c) (d) (e) (f) (g) (h) (i). An additional sheet may be added if necessary to conform with said requirements.

(a) Corner location: Township 38 North

Range 4 East/~~West~~

Town/City/Village ~~XXXXXXXXX~~ Minocqua

County Oneida

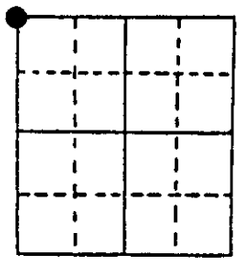

Section 27

(b) (f) (g) (h) Description of monument found at this corner and if it was accepted, state all evidence (material, testimonial, occupational, plats, records, other monuments) used as a basis for accepting. If not accepted or if nothing was found, state evidence used as basis for establishing location. If reestablished through lost corner proportionate methods, indicate all monuments, distances and directions used to establish.

The original Government Survey was performed by Alexander Anderson in April & May, 1865. A wood post was set: Hemlock 9" N32W, 5 lks., Hemlock 10" S45E, 11 lks.

Nekoosa Papers used this corner in surveys they did in the area in the 1950s. Corner listed as iron pipe or cap.

I found and accepted: Iron Pipe, 2" dia., 20" above ground with brass cap stamped as shown below. I established the following witnesses: (nail in trees) N. Pine 8" S15W, 69.90'; N. Pine 8" S31W, 79.55'; N. Pine 8" S45W, 77.55'; Scotch Pine 4" S35W, 32.87'; set plastic survey marker sign N27E, 1'.

(c) (d) (e) Plan view of corner with ties to at least 4 witness monuments. If in disagreement with previously established corner, show the distances between the two corners and also indicate the ties to the disputed corner.

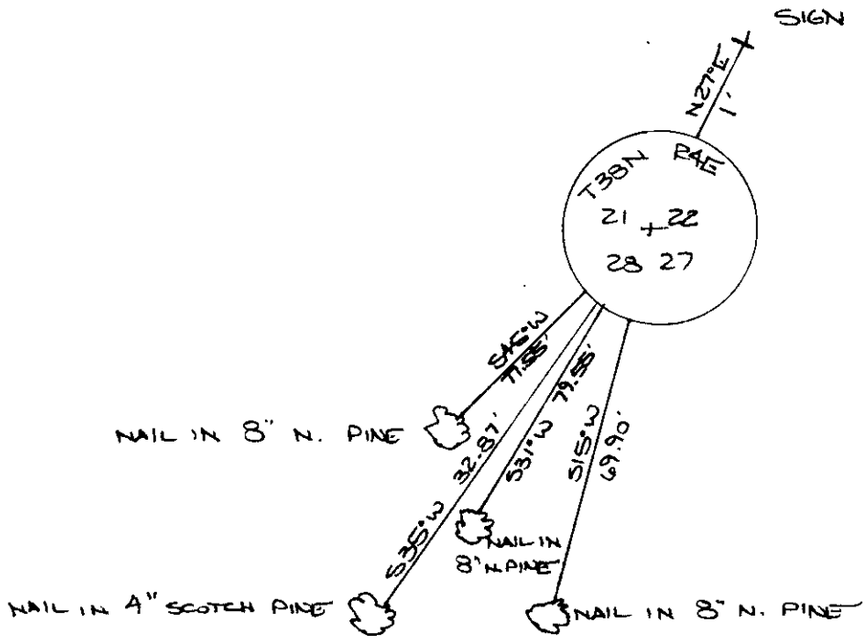

REGISTER OF DEEDS OFFICE
ONEIDA COUNTY WIS
FILED
FEB 16 1989
At ____ O'Clock ____ M
THOMAS M. LEIGHTON
REGISTER OF DEEDS

(i) I, JEFFREY W. AUSTIN S-1885

(type or print name) certify that the corner location on this record was determined by me or under my direction and control and that this U.S. Public Land Survey Monument Record is correct and complete to the best of my knowledge and belief.

Signature

FEBRUARY 1, 1989
Date

WISCONSIN
Jeffrey W. Austin
S—1885
Minocqua, WIS.
LAND SURVEYOR

Index No. R-13

3804210000