


U.S. PUBLIC LAND SURVEY MONUMENT RECORD

Note: This form is intended and designed to fulfill all requirements of Wisconsin Administrative Code, Chapter A-E 7.08 U.S. Public Land Survey Monument Record (3)(a-i).

(a) CORNER LOCATION
 1/4 Cor. of Secs. 6 & 31
 Township 37 & 38 North
 Range 4 East of the 4th P.M.
 Town of Lynne/Minocqua
 County of Oneida

WISCRS - Oneida County
 N: 198,891.14 USft
 E: 105,072.12 USft
 Datum: NAD 83(2011)
 GNSS Method: Real-Time Network
 GNSS Control: WISCORS VRS

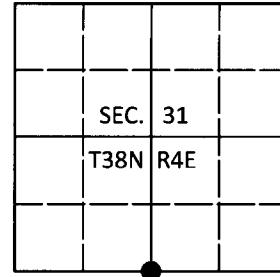

(b) HISTORY OF ORIGINAL CORNER ESTABLISHMENT

Original Surveyor: Alexander Anderson Original Accessories:
 Birch 13 N24°W, 20 lks.
 Date of Survey Commenced: July, 1864 Hemlock 9 S19°E, 4 lks.
 Completed: July, 1864


(b)(f)(g)(h) Description of monument found at this corner and if it was accepted, state all evidence (material, testimonial, occupational, plats, records, other monuments) used as a basis for accepting. If not accepted or if nothing was found, state evidence used as basis for establishing location. If re-established through lost corner proportionate methods, indicate all monuments, distances and directions used to establish. Indicate type of monument and sign post found or set.

March 10, 1987: Map of Sec. 31 by William H. Stuth, RLS indicates no monument at this location.

June 15, 2017: Jeff Austin thoroughly searched this corner finding it to be lost with no evidence of the GLO survey or any subsequent survey in existence. As detailed below, a 1" diam., 28" long iron pipe with a 2" diam. aluminum cap flush with the ground surface was set at the proportionate distance between controlling corners. The distance West to high land is 50 ft. comparing well to the GLO distance of 1 chain. An old East-West blazed line bears North, 12 ft., likely from the Stuth survey. Accessories were established as shown below. A white vinyl sign post was set Northwest, 1 ft.

The coordinate value shown has been verified by at least one of the following methods: 1) comparison to a previously GPS determined published value; 2) the value is the average of two or more GPS observations at a markedly different time; 3) one or more distances were measured back to the GPS observed corner from temporary GPS observed offset locations.

(c)(d)(e) Plan view of corner with ties to at least 4 witness monuments. If in disagreement with previously established corner, show the distances between the two corners and also indicate the ties to the disputed.

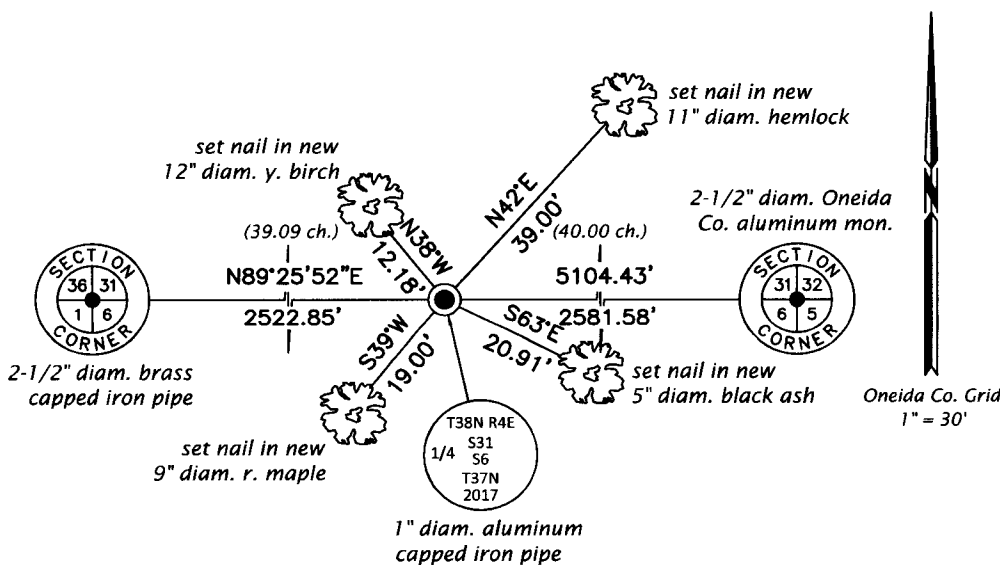

REGISTER OF DEEDS OFFICE
 ONEIDA COUNTY
 FILED

JUL 11 2017

AT _____ O'CLOCK _____ M
 KYLE J. FRANSON
 REGISTER OF DEEDS

(i) I, Michael J. Romportl, Professional Land Surveyor No. S-1624, hereby certify that the corner location on this record was determined by me or under my direction and control and that this U.S. Public Land Survey Monument Record is correct and complete to the best of my knowledge and belief.



Michael J. Romportl 7/11/2017
 Signature Date