


U. S. PUBLIC LAND SURVEY MONUMENT RECORD

Note: This form is intended and designed to fulfill all requirements of Wisconsin Administrative Code, Chapter A-E 7.08 U.S. Public Land Survey Monument Record(3)(a)(b)(c)(d)(e)(f)(g)(h)(i). An additional sheet may be added if necessary to conform with said requirements.

(a) Corner location: Township 38 North
Range 5 East

Town of Minocqua

Oneida County, Wisconsin

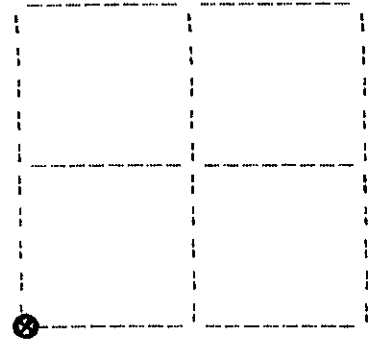

Section 2

(b)(f)(g)(h) Description of monument found at this corner and if it was accepted, state all evidence (material, testimonial, occupational, plats, records, other monuments) used as a basis for accepting. If not accepted or if nothing was found, state evidence used as basis for establishing location. If reestablished through lost corner proportionate methods, indicate all monuments, distances and directions used to establish. Indicate type of monument found or set and sign post.

October, 1863: Alexander Anderson, US deputy surveyor notes the following: 80.00 set post for cor to secs 2,3,10&11: w.pine 10 N82E, 96; aspen 5 N16W, 14.


July 12, 1933: Hall page 164 notes the following: 73.702 rt angle west .57 to orig cor secs 2,3,10&11. corrected this line N to 1/4 S. 10-27-33 identified this cor by one orig bearing marks ok. aspen not evident. iventhal has a pople post set about right. set pine post & mark new bearings to corner as located yesterday by true course & record dist. from stp. (S82W, .96): w.pine 10° S22-03W, 1.14; w.pine 7° S14-25E, 1.022; y.pine 9° N73E, .50 this has been scribed on E side 6 or 8 years ago, party must have lacked notes. may, 1934: plant 4' galv pipe with stamped bronze cap (wis conservation dept mon) 11" exposed at corner as above described. the old bt stp hung over cut bank of grade improved for truck trail 10 & was placed in rhinelander museum.

September 29, 1990: I found and accepted a 2-1/2" dia. iron post, 10" above ground with 3" dia. WCD brass cap marked as shown below. I found the following witnesses: n.pine stp.(hall) 22° N72E, 32.8 feet; old pine stp.(hall) S15E, 66.5 feet; blazed w.pine stp.(hall) 28° S21W, 75.8 feet. I established the following witnesses: set 1" dia. 30" long witness pipes: S89-23E, 31.52 feet; S30-55W, 55.41 feet; N73-29W, 50.97 feet; also set drillhole in 7'x3'x5' granite boulder N30-08E, 23.53 feet; set plastic sign post north, 1 foot.

(c)(d)(e) Plan view of corner with ties to at least four witness monuments. If in disagreement with previously established corner, show the distances between the two corners and also indicate the ties to the disputed corner.

1. 1" x 30" iron pipe
S89-23E, 31.52 feet
2. 1" x 30" iron pipe
S30-55W, 55.41 feet
3. 1" x 30" iron pipe
N73-29W, 50.97 feet
4. drillhole in boulder
N30-08E, 23.53 feet

(not to scale)

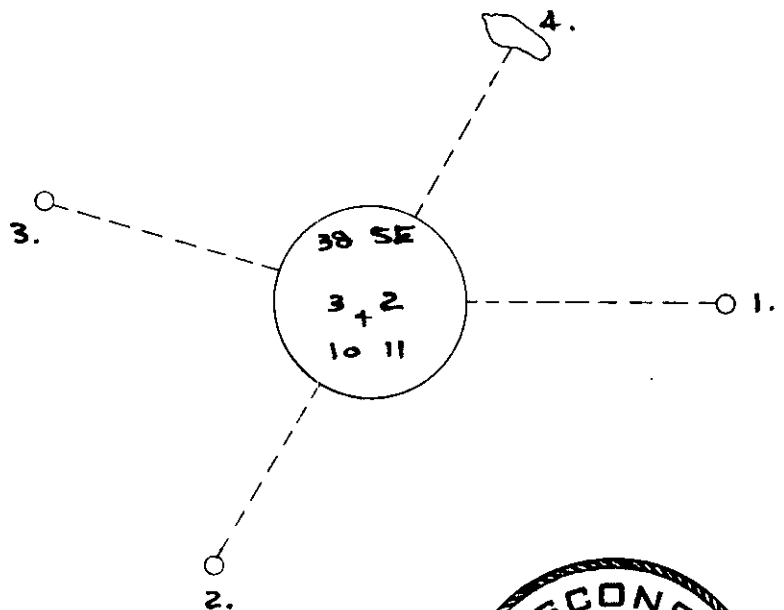

I, Jeffrey W. Austin, Registered Land Surveyor S-1885 certify that the corner location on this record was determined by me or under my direction and control and that this U.S. Public Land Survey Monument Record is correct and complete to the best of my knowledge and belief.



Jeffrey W. Austin
Signature _____ Date September 30, 1990

Index no. E-17

3805030000