

CERTIFIED LAND CORNER RESTORATION

State of Wisconsin }
County of Oneida } ss.

I Terry T. Golding, do hereby certify that on the 5th day of October, 19 81, I found evidence of the north one-quarter corner of section 7 Township 38 north Range 5 east, Fourth Principal Meridian, as described hereon; and that from this evidence I established a new monument and accessories as described hereon to perpetuate the original location of this corner:

Description of original monument and accessories and subsequent restorations:


October 12, 1863 - Alexander Anderson, deputy surveyor, set wood post witnessed by a 14" Hemlock, N37°W, 37 links (24.42 feet) and by a 16" W. Pine, S74°W, 16 links (10.56 feet).

Description of corner evidence found:

3" x 3" cedar post up 12".
13" W. Pine, S60°E, 37.56 feet to P.K. nail I set in lower blaze.
I believe this to be the best evidence of the corner position, closely matching original distances from the NW corner, section 7, matching 1960 Nepco survey by Ken Voyt and matching clearing lines of the NE¼ of the NW¼ .

Description of monument and accessories I established to perpetuate the location of this corner:

Replaced 3" x 3" cedar post with an aluminum Oneida County Survey Marker, 2" dia. and 30" long with a 3/4" dia. stamped cap.
Reset wood post along side.
Made bearing trees (scribed) with P.K. nails set in lower blaze as follows :
7" N. Pine, N11°E, 32.45'
13" Oak, N65°W, 22.32'
13" W. Pine, S60°E, 37.56' (existing).

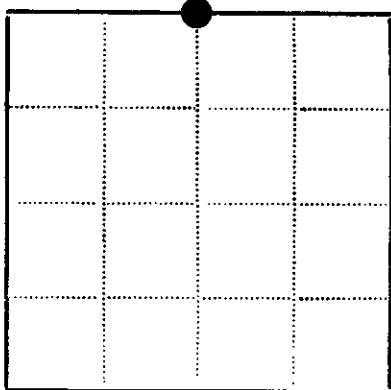

● - Corner monument restored
□ -

Resident witnesses.....

Dated at Minocqua Wisconsin, this 18 day of May 1982.....

Signature Terry T. Golding Title Reg Land Surveyor
(County Surveyor, Registered Land Surveyor, or other duly authorized official)

Surveyors Registration No. S- 1468

Office of REGISTER OF DEEDS County of Oneida

I hereby certify that the within instrument was filed in this office for record on the 17th day of September 1982 and was filed in Book No. Page No. of County Records.

Signature Tous Verage Kueden Title REGISTER OF DEEDS

Township....., Range....., Section....., Index No....., Page No.....

17-3