

REGISTER OF DEEDS OFFICE
ONEIDA COUNTY, WIS

FILED
FEB 8 1991

At _____ O'Clock _____ M
THOMAS H. LEIGHTON
REGISTER OF DEEDS

U.S. PUBLIC LAND SURVEY MONUMENT RECORD


Notes: This form is intended and designed to fulfill all requirements of Wisconsin Administrative Code, Chapter ATC 7.08 U.S. Public Land Survey Monument Record and the record of filing thereof. An additional sheet may be added if necessary to conform with said requirements.

(a) Corner location: Township 38 North

Range 5 East

Town of Minocqua

Oneida County, Wisconsin

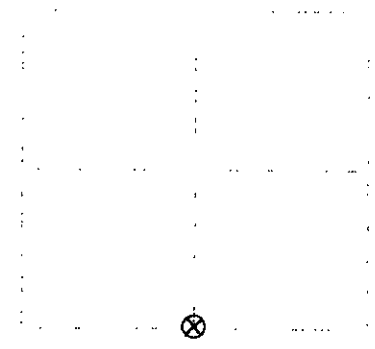

Section 12

Bring up a description of monument found at this corner and if it was accepted, state all evidence material, testimonial, occupational, plats, records, other monuments, used as a basis for accepting. If not accepted or if nothing was found, state evidence used as basis for establishing location. If reestablished through lost corner proportionate methods, indicate all monuments, distances and directions used to establish. Indicate type of monument found or set and sign post.

October, 1880: Alexander Anderson, US deputy surveyor notes the following: 40.40 set 1/4 sec. post: aspen 6 N46W, 56 ft., aspen 6 N46E, 34 ft.



February 3, 1970: I found and accepted a 20" pine stump post with iron cap 1" above ground marked as shown below. I found the following witness posts: pine stump (100) S46E, 32.12 feet; jack pine dead (100) 111 S60W, 74.11 feet. I established the following witness posts: set nail in aspen 7" N24W, 7.79 feet; set nail in aspen 7" N46E, 32.96 feet; set nail in gray w. spruce 7" S66E, 11.83 feet; set nail in pine 20" S60W, 74.87 feet; set plastic sign post 4 feet.

General: This view of corner with ties to at least four witness monuments. If in disagreement with previously established corner, show the distances between the two corners and also indicate the tie to the disputed corner.

1. nail in aspen 7" N46E, 32.96 feet.
2. nail in w.spruce 7" S66E, 11.83 feet.
3. nail in n.pine 20" S60W, 74.87 feet.
4. nail in aspen 7" N24W, 7.79 feet.

(not to scale)

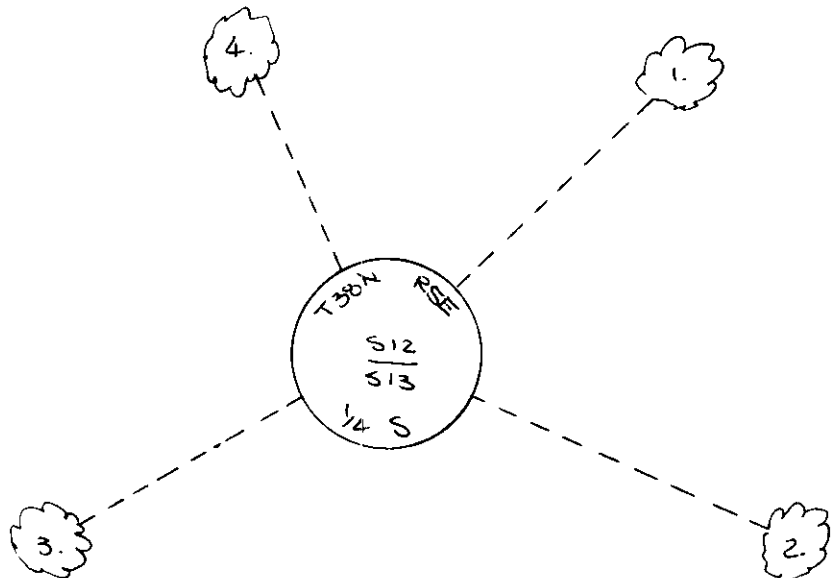

I, Jeffrey W. Austin, Registered Land Surveyor S-1885 certify, that the corner location on this record was determined by me or under my direction and control and that this U.S. Public Land Survey Monument Record is correct and complete to the best of my knowledge and belief.



Jeffrey W. Austin

2-7-1991

Index no. J-23

3805120020