


**U.S. PUBLIC LAND SURVEY MONUMENT RECORD**

Note: This form is intended and designed to fulfill all requirements of Wisconsin Administrative Code, Chapter A-E 7.08 U.S. Public Land Survey Monument Record(3)(a)(b)(c)(d)(e)(f)(g)(h)(i). An additional sheet may be added if necessary to conform with said requirements.

(a) Corner location: Township 38 North  
Range 5 East

Town of Minocqua

Oneida County, Wisconsin

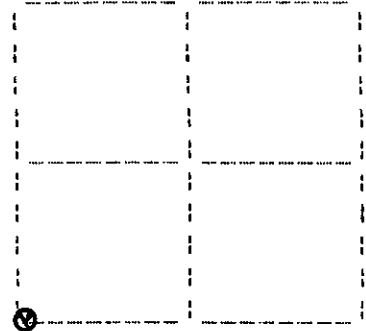

**Section 13**

(b)(f)(g)(h) Description of monument found at this corner and if it was accepted, state all evidence (material, testimonial, occupational, plats, records, other monuments) used as a basis for accepting. If not accepted or if nothing was found, state evidence used as basis for establishing location. If reestablished through lost corner proportionate methods, indicate all monuments, distances and directions used to establish. Indicate type of monument found or set and sign post.

October, 1863: Alexander Anderson, US deputy surveyor notes the following: 80.00 set post for cor. to secs. 13,14,23&24: aspen 10 N44°W, 28 lks.; aspen 8 N23°E, 15 lks.


July 16, 1935: Hall page 182 notes the following: found orig. smx13, set wis. cons. dept. mon.: jack pine 10° N70-35E, .69; jack pine 9° S47-05W, 1.015; y.pine 4° S51-20E, .428.

September 23, 1990: I found and accepted a 2-1/2" dia. iron post, 6" above ground with 3" dia. WCD brass cap marked as shown below. I found the following witnesses: rotten stump(hall) N71°E, 46.0 feet; rotten stump(hall) S45°W, 67.6 feet; set nail in n.pine(hall) 18° S52°E, 28.72 feet; set nail in n.pine 16° N35°W, 22.35 feet; set nail in n.pine 15° S69°W, 13.10 feet. I established the following witnesses: set nail in w.pine 8° N71°E, 61.60 feet; set plastic sign post north, 1 foot.

(c)(d)(e) Plan view of corner with ties to at least four witness monuments. If in disagreement with previously established corner, show the distances between the two corners and also indicate the ties to the disputed corner.

1. nail in n.pine 18"  
S52E, 28.72 feet
2. nail in n.pine 16"  
N35W, 22.35 feet
3. nail in n.pine 15"  
S69W, 13.10 feet
4. nail in w.pine 8"  
N71E, 61.60 feet

(not to scale)

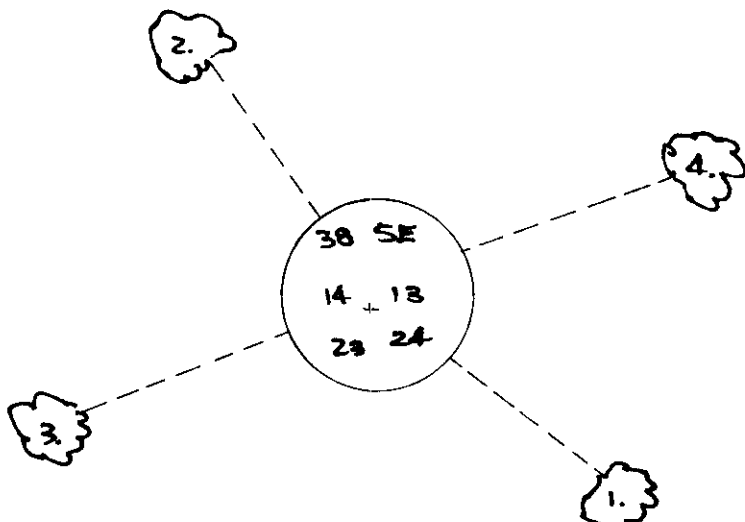

I, Jeffrey W. Austin, Registered Land Surveyor S-1885 certify that the corner location on this record was determined by me or under my direction and control and that this U.S. Public Land Survey Monument Record is correct and complete to the best of my knowledge and belief.

*Jeffrey W. Austin*  
Signature Date September 30, 1990

Index no. N-21

3805140000