


**U.S. PUBLIC LAND SURVEY MONUMENT RECORD**

Note: This form is intended and designed to fulfill all requirements of Wisconsin Administrative Code, Chapter A-E 7.08 U.S. Public Land Survey Monument Record (3) (a) (b) (c) (d) (e) (f) (g) (h) (i). An additional sheet may be added if necessary to conform with said requirements.

(a) CORNER LOCATION: Plane Coordinates  
 1/4 Cor. of Secs. 13 & 14 X:  
 Township 38 North Y:  
 Range 5 East of the 4th P.M. Datum:  
 Town of Minocqua County of Oneida

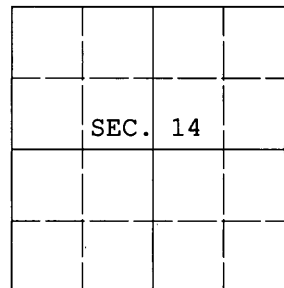


(b) HISTORY OF ORIGINAL CORNER ESTABLISHMENT


Original Surveyor: Alexander Anderson Original Accessories:  
 Date of Survey: Commenced Oct. 6, 1863 aspen 5 S65°E, 12 lks.  
 Completed Oct. 13, 1863 aspen 5 S76°W, 32 lks.

(b) (f) (g) (h) Description of monument found at this corner and if it was accepted, state all evidence (material, testimonial, occupational, plats, records, other monuments) used as a basis for accepting. If not accepted or if nothing was found, state evidence used as basis for establishing location. If re-established through lost corner proportionate methods, indicate all monuments, distances and directions used to establish. Indicate type of monument and sign post found or set.


December 1, 2010: I found and accepted a 2-1/2" diam. iron post with brass cap projecting 15" above the ground and marked as shown below. I was unable to locate any record supporting this monument, however GPS measurements to the controlling corners lead me to believe it was set proportionate measure by Hall/CCC. I established accessories as shown below and set a white plastic sign post bearing Northwest, 1 ft. dist.

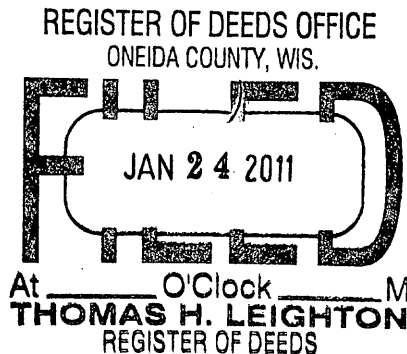

(c) (d) (e) Plan view of corner with ties to at least 4 witness monuments. If in disagreement with previously established corner, show the distances between the two corners and also indicate the ties to the disputed.

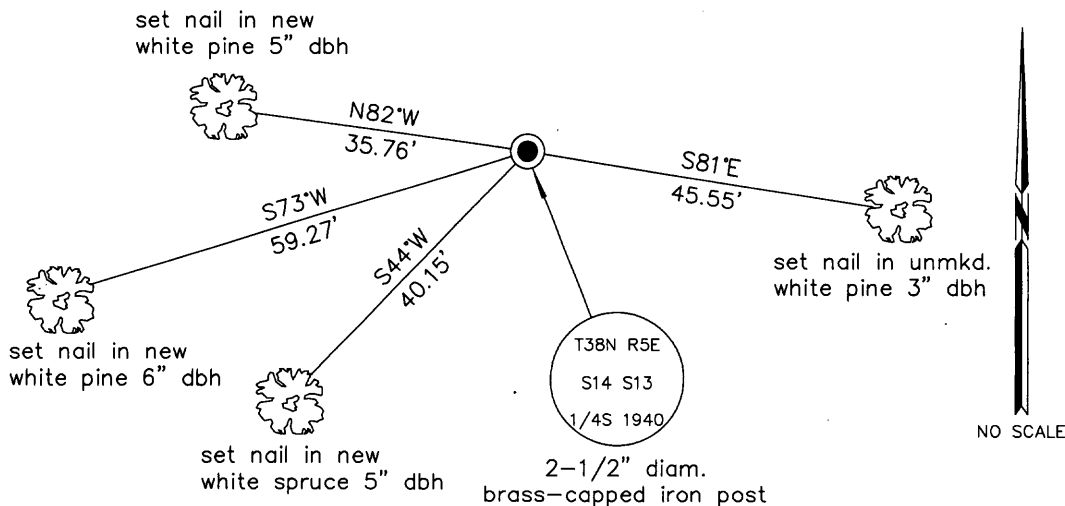

(i) I, Jeffrey W. Austin, Registered Land Surveyor No. S-1885, hereby certify upon honor that the corner location on this record was determined by me or under my direction and control and that this U.S. Public Land Survey Monument Record is correct and complete to the best of my knowledge and belief.

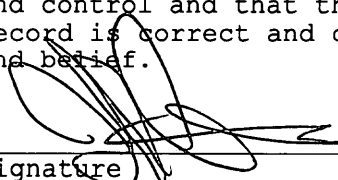 \_\_\_\_\_  
 Signature Date DEC. 31, 2010

