U.S. PUBLIC LAND SURVEY MONUMENT RECORD

Note: This form is intended and designed to fulfill all requirements of the Wisconsin Administrative Code, Chapter A-E 7.08 U.S. Public Land MonumentRecord (3)(a)(b)(c)(d)(e)(f)(g)(h)(i). An additional sheet may be added if necessary to conform with said requirements.

REGISTER OF DEEDS OFFICE
ONEIDA COUNTY
FILED

NOV 23 2016

AT_____O'CLOCK_____M
KYLE J. FRANSON
REGISTER OF DEEDS

(a) CORNER LOCATION:
South Quarter Corner of Section 19
Township 38 North
Range 5 East
Town of Minocqua
County of Oneida

COORDINATES
North: 210029.337
East: 136811.923
Projection: WISCORS - Oneida
Datum: NAD 1983(2011)
Method: RTK - Offset

(RECORDING AREA)

SECTION 19

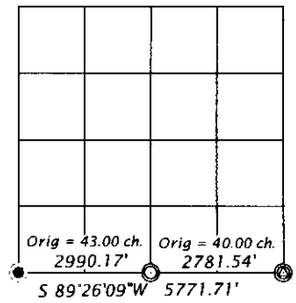

(b) HISTORY OF ORIGINAL CORNER ESTABLISHMENT

Original Surveyor: Alexander Anderson
Date of Survey: Commenced October 6, 1863
Completed October 13, 1863
Original B.T.'S: 10" Spruce, N 22°W, 17 lks.
8" Spruce, S 12°W, 21 lks.

(f)(g)(h) DESCRIPTION OF MONUMENT FOUND AT THIS CORNER AND IF IT WAS ACCEPTED, STATE ALL EVIDENCE (MATERIAL, TESTIMONIAL, OCCUPATIONAL, PLATS, RECORDS, OTHER MONUMENTS) USED AS A BASIS FOR ESTABLISHING LOCATION. IF NOT ACCEPTED OR IF NOTHING WAS FOUND, STATE EVIDENCE USED AS BASIS FOR ESTABLISHING LOCATION. IF REESTABLISHED THROUGH LOST CORNER PROPORTIONATE METHODS, INDICATE ALL MONUMENTS, DISTANCES AND DIRECTIONS USED TO ESTABLISH. INDICATE TYPE OF MONUMENT AND SIGN POST FOUND OR SET.

1957 - Becker, Ownes - Illinois surveyor, mapped by W. H. Stuth, 5/21/86 filed in NEPCO Book 2, page 101; identifies corner monument as a placed iron pipe or cap witnessed bt's: 5" Spruce, S 82°E, 5.9'; 9" Spruce, S 47°E, 31.7'; 8" Spruce, N 24°E, 31.7'. This map is identified as a staff compass survey using corners found.

2016 - September 28 - James D. Rein, PLS, No. 1234 - After performing survey ties to along the south line of Section 19, (see my U.S.P.L.S. Mon. Rec. for cor. Sections 19-24-25-30 dated 9/02/07), I determine that Becker's attempt at re-establishing the corner is based on proportionate measurement to an erroneous section corner. I thus re-established the position by single proportionate measurement between the section corners as shown in the plan view.

(c)(d)(e) PLAN VIEW OF CORNER WITH TIES TO AT LEAST 4 WITNESS MONUMENTS. IF IN DISAGREEMENT WITH PREVIOUSLY ESTABLISHED CORNER, SHOW THE DISTANCE BETWEEN THE TWO CORNERS AND ALSO INDICATE THE TIES TO THE DISPUTED CORNER.

Bearings Oneida County Grid

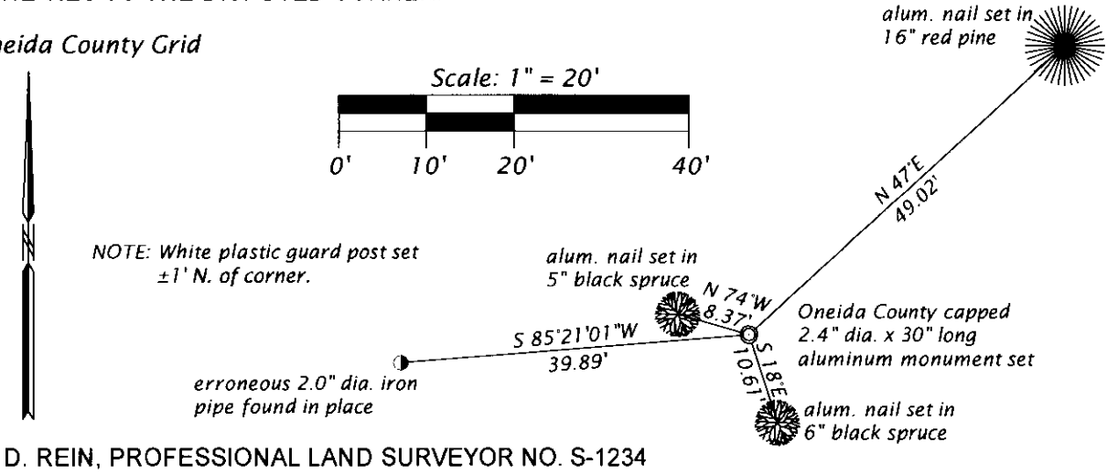

(i) I, JAMES D. REIN, PROFESSIONAL LAND SURVEYOR NO. S-1234 HEREBY CERTIFY THAT THE CORNER LOCATION ON THIS RECORD WAS DETERMINED BY ME OR UNDER MY DIRECTION AND CONTROL AND THAT THIS U.S. PUBLIC LAND SURVEY MONUMENT RECORD IS CORRECT AND COMPLETE TO THE BEST OF MY KNOWLEDGE AND BELIEF.

SIGNATURE

11-16-16
DATE

WISCONSIN
JAMES D. REIN
S-1234
MINOCQUA, WI
LAND SURVEYOR

380519 0020

INDEX NO. R-3