U.S. PUBLIC LAND SURVEY MONUMENT RECORD

Note: This form is intended and designed to fulfill all requirements of Wisconsin Administrative Code, Chapter A-E 7.08 U.S. Public Land Survey Monument Record (3)(a-i).

(a) CORNER LOCATION
Wit. Meander Cor. of Secs. 24 & 25
Township 38 North
Range 5 East of the 4th P.M.
Town of Minocqua
County of Oneida

WISCRS - Oneida County
N: 209,828.62 USft
E: 161,723.87 USft
Datum: NAD 83(2011)
GNSS Method: RTN - Direct
GNSS Control: WISCORS VRS

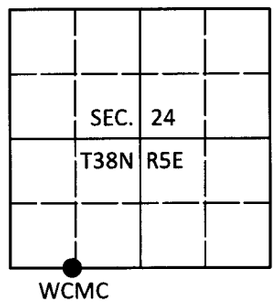

(b) HISTORY OF ORIGINAL CORNER ESTABLISHMENT

Original Surveyor: Alexander Anderson

Original Accessories:

Date of Survey Commenced: Oct. 6, 1863
Completed: Oct. 13, 1863

Spruce 6" S10°W, 9 lks.
Tamarack 6" N84°W, 21 lks.

(b)(f)(g)(h) Description of monument found at this corner and if it was accepted, state all evidence (material, testimonial, occupational, plats, records, other monuments) used as a basis for accepting. If not accepted or if nothing was found, state evidence used as basis for establishing location. If re-established through lost corner proportionate methods, indicate all monuments, distances and directions used to establish. Indicate type of monument and sign post found or set.

October 10, 1940: Notes by Hall in CCC Book 13 on page 1 indicate he recovered remains of the Northwest GLO bearing tree and set a wood post witnessed by spruce 5" S27°E, 7.8' and spruce 4" S39°W, 23.0'.

January 10, 1991: OCS Map No. L-1124 by David F. McMullen indicates corner is marked by an iron pipe found.

June 1, 2018: I found and accepted a 2" diam. iron pipe at the edge of open water. I was unable to recover evidence of Hall's bearing trees, but an unmarked tamarack stump (GLO) bears N86°W, 21 lks. As a witness to the iron pipe, I set a 2-1/2" diam., 60" long aluminum pipe with a 3-1/4" diam. Oneida Co. aluminum cap projecting 4" above the bog surface. I found or established accessories as shown below. I set a white vinyl sign post bearing Northeast, 0.8 ft.

The coordinate value shown has been verified by at least one of the following methods: 1) comparison to a previously GPS determined published value; 2) the value is the average of two or more GPS observations at a markedly different time; 3) one or more distances were measured back to the GPS observed corner from temporary GPS observed offset locations.

(c)(d)(e) Plan view of corner with ties to at least 4 witness monuments. If in disagreement with previously established corner, show the distances between the two corners and also indicate the ties to the disputed.

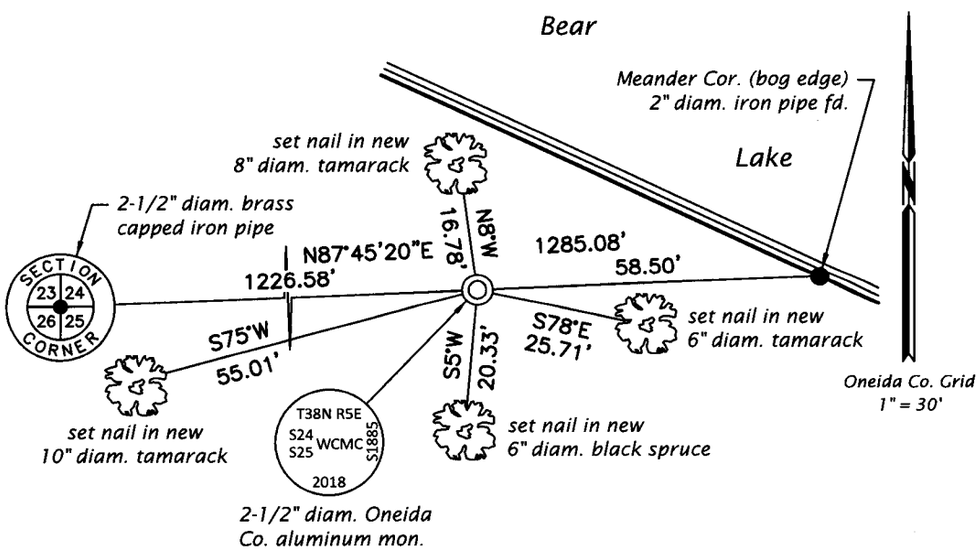

WISCONSIN
JEFFREY W. AUSTIN
S-1885
MINOCQUA, WI
LAND SURVEYOR

REGISTER OF DEEDS OFFICE
ONEIDA COUNTY
FILED

JUN 13 2018

KYLE J. FRANSON
REGISTER OF DEEDS

(i) I, Jeffrey W. Austin, Professional Land Surveyor No. S-1885, hereby certify that the corner location on this record was determined by me or under my direction and control and that this U.S. Public Land Survey Monument Record is correct and complete to the best of my knowledge and belief.

Signature

JUNE 4, 2018
Date

3805240032 (INDEX NO. R-21,22)