


U. S. PUBLIC LAND SURVEY MONUMENT RECORD

Notes: This form is intended and designed to fulfill all requirements of Wisconsin Administrative Code, Chapter A-E 7.08 U.S. Public Land Survey Monument Record (31 CFR 101.10) and its amendments. An additional sheet may be added if necessary to conform with said requirements.

(a) Corner location: Township 38 North
 Range 5 East
 Town of Minocqua
 Oneida County, Wisconsin

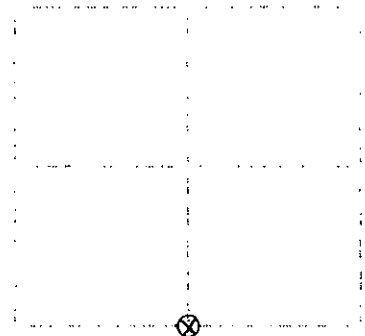

Section 27

(b) (1) (i) Description of monument found at this corner and if it was accepted, state all evidence (material, testimonial, occupational, plans, records, other monuments) used as a basis for accepting. If not accepted or if nothing was found, state evidence used as basis for establishing location. If reestablished through lost corner proportionate methods, indicate all monuments, distances and directions used to establish. Indicate type of monument found or set and sign post.

October, 1860: Alexander Anderson, LS deputy surveyor notes the following: 40.0' set 1/4 sec post: w.pine 7 N37-1/2E, 12 lks.; y.pine 7 S74E, 8 lks.

August 14, 1900: Hall, page 185 notes the following: find good post for orig 1/4 S between 27104 & old w.pine BT marks plain. This is not called for in notes & stands S72E, 144' on re-drive post, stands on 5 slope about 1 rod north of creek bottom. orig. orig. N44E, 112'; new w.pine 24' N56W, 1218.


September, 1900: northwoods surveyors. iron pipe 29' w.pine (orig.) S69E, 9.5'; 20' pine stp. (Hall 1900) N53W, 14.3'; 11' w.pine N07E, 33.01'; 5' w.pine N66W, 19.9'; 15' w.pine N79E, 21.6'.

November 7, 1990: I found and accepted a 32" long, 1" dia. iron pipe and wood post. I replaced pipe with an aluminum post, 30" long, 2-1/2" dia., 24" in the ground with aluminum cap marked as shown below. I buried a "deep 1" magnet at the base of post. I found the following witnesses: old pine stp. orig S69E, 10.7' feet; old pine stp. (Hall 1900) N54W, 14.3' feet; blazed w.pine stp. (northwoods) N30E, 57.0' feet; blazed w.pine stp. (northwoods) 12" N57W, 20.8' feet; blazed w.pine stp. (northwoods) 18" N63E, 21.7' feet. I established the following witnesses: set 24" long, 1" dia. iron pipes N75-00E, 33.01' feet; N0-39E, 32.22' feet; N88-50W, 37.02' feet; S15-39W, 112.24' feet; set plastic sign post north, 1' foot.

(c) (i) Plan view of corner with ties to at least four witness monuments. If in disagreement with previously established corner, show the distances between the two corners and also indicate the ties to the disputed corner.

- 1. 1" dia. iron pipe
N75-00E, 33.01 feet.
- 2. 1" dia. iron pipe
N0-39E, 32.22 feet.
- 3. 1" dia. iron pipe
N88-50W, 37.02 feet.
- 4. 1" dia. iron pipe
S15-39W, 112.24 feet.

(not to scale)

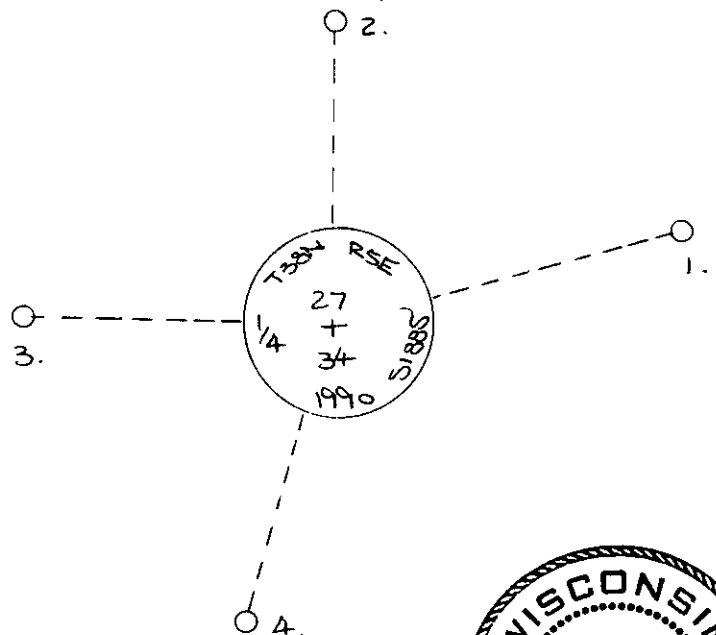

I, Jeffrey W. Austin, Registered Land Surveyor S-1885 certify that the corner location on this record was determined by me or under my direction and control and that this U.S. Public Land Survey Monument Record is correct and complete to the best of my knowledge and belief.



Jeffrey W. Austin
 NOVEMBER 30, 1990
 Surveyor

Index no. V-15

3805270020