U.S. PUBLIC LAND SURVEY MONUMENT RECORD

Note: This form is intended and designed to fulfill all requirements of Wisconsin Administrative Code, Chapter A-E 7.08 U.S Public Land Survey Monument Record (3) (a) (b) (c) (d) (e) (f) (g) (h) (i). An additional sheet may be added if necessary to conform with said requirements.

(a) Corner location: Township 38 North

Range 6 East ~~West~~

Town/~~City/Village~~ Hazelhurst

County Oneida

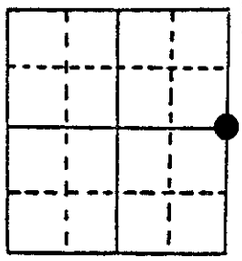

Section 1

(b) (f) (g) (h) Description of monument found at this corner and if it was accepted, state all evidence (material, testimonial, occupational, plats, records, other monuments) used as a basis for accepting. If not accepted or if nothing was found, state evidence used as basis for establishing location. If reestablished through lost corner proportionate methods, indicate all monuments, distances and directions used to establish. Indicate type of monument found or set and sign post.

1860 - Corner was originally set by Alfred Millard. He tied the corner to the following bearing trees: W.P. 36" S33°W, 35 lks and Aspen 6" S54°E, 22 lks.
1896 - Vaughn found and accepted original corner.
1947 - Hennig found orig. bearing tree stump, a 48" Y. Pine stump. He reset the 1/4 corner based on this evidence. He set an Oak post and tied to the following bearing trees: 48" Y. Pine stump, S27°W, 23'; 5" Spruce, N30°E, 43.6'; 6" Oak, S3°W, 51.5'.
1986 - D.N.R. found a 2" iron pipe at corner location & replaced it with a W.C.D. brass capped iron pipe.
1989 - I found & accepted the W.C.D. iron pipe.

(c) (d) (e) Plan view of corner with ties to at least 4 witness monuments. If in disagreement with previously established corner, show the distances between the two corners and also indicate the ties to the disputed corner.

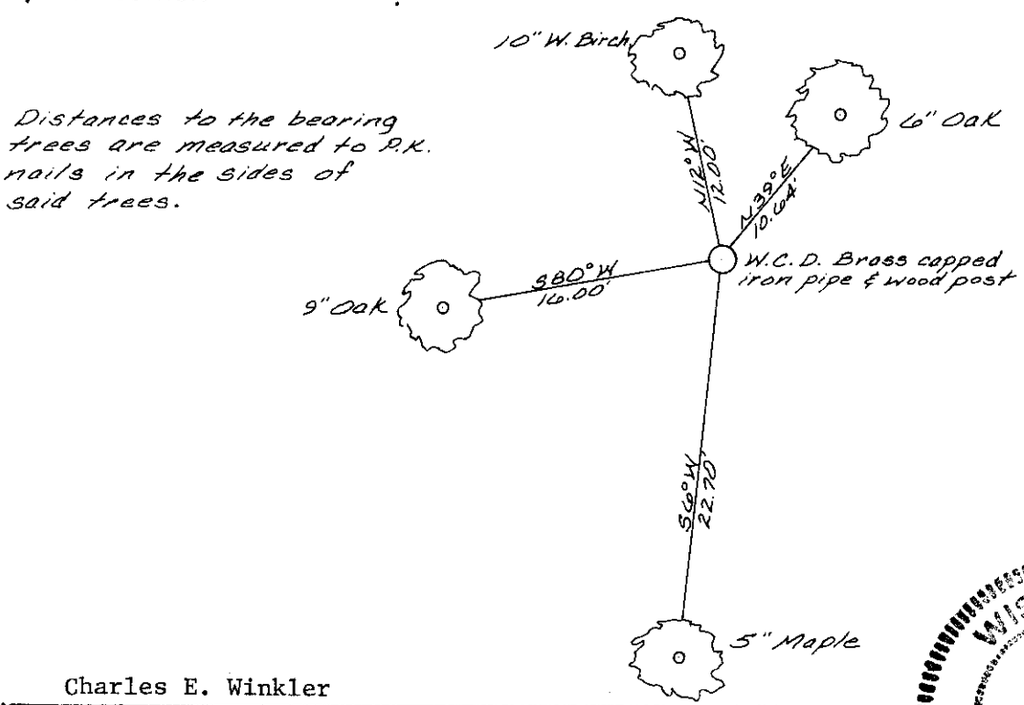

(i) I, Charles E. Winkler (type or print name) certify that the corner location on this record was determined by me or under my direction and control and that this U.S. Public Land Survey Monument Record is correct and complete to the best of my knowledge and belief.

Charles E. Winkler 11-30-89

Signature Date

WISCONSIN CHARLES E. WINKLER S-1671 MINOCQUA, WIS. LAND SURVEYOR

Index No. 2-25

3806012000