U.S. PUBLIC LAND SURVEY MONUMENT RECORD

Note: This form is intended and designed to fulfill all requirements of the Wisconsin Administrative Code, Chapter A-E 7.08 U.S. Public Land MonumentRecord (3)(a)(b)(c)(d)(e)(f)(g)(h)(i). An additional sheet may be added if necessary to conform with said requirements.

REGISTER OF DEEDS OFFICE
ONEIDA COUNTY
FILED

APR 09 2015

AT _____ O'CLOCK _____ M
KYLE J. FRANSON
REGISTER OF DEEDS

(RECORDING AREA)

(a) CORNER LOCATION:
West Quarter Corner of Section 8
Township 38 North
Range 6 East
Town of Hazelhurst
County of Oneida

COORDINATES - WIS CCS
North: 222940.583
East: 170642.736
Control Station: WISCOORS Network
Latitude:
Longitude:
Datum: NAD83 (2011)
Method: Offset from RTK gps control

SECTION 8

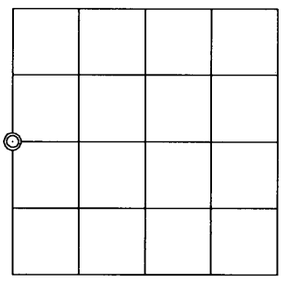

(b) HISTORY OF ORIGINAL CORNER ESTABLISHMENT
Original Surveyor: Alexander Anderson
Date of Survey: Commenced Sept. 28, 1863
Completed Oct. 5, 1863
Original B.T.'S Y. Pine 9" N79°W 30 lks
Y. Pine 8 N66-1/2°E 4 lks

(f)(g)(h) DESCRIPTION OF MONUMENT FOUND AT THIS CORNER AND IF IT WAS ACCEPTED, STATE ALL EVIDENCE (MATERIAL, TESTIMONIAL, OCCUPATIONAL, PLATS, RECORDS, OTHER MONUMENTS) USED AS A BASIS FOR ESTABLISHING LOCATION. IF NOT ACCEPTED OR IF NOTHING WAS FOUND, STATE EVIDENCE USED AS BASIS FOR ESTABLISHING LOCATION. IF REESTABLISHED THROUGH LOST CORNER PROPORTIONATE METHODS, INDICATE ALL MONUMENTS, DISTANCES AND DIRECTIONS USED TO ESTABLISH. INDICATE TYPE OF MONUMENT AND SIGN POST FOUND OR SET.

April, 1970 - John H. Fisher, map of survey in Sections 7 & 18, legends a found concrete monument at the E 1/4 corner of Section 7, referenced by two bearing trees: 12" Jack Pine, South, 14.5' & 8" White Pine, S66°W, 20.6'.

March 4, 1971 - Bill Egtvedt (NEPCO - B file) map legends an "iron pipe or brass cap" at the corner location on a map of Section 8.

July 12, 1982 - John H. Fisher & Assoc. field notes for McNellis survey in Sections 8 & 9 describes corner as being monumented by a 2" I.P.

July 16, 2014, James D. Rein found a 2.5" dia. x 30" long iron pipe at the corner location along with both bearing trees (now dead) shown on the 1970 Fisher survey. We replaced said iron pipe with a 2.4" dia. x 30" long flange bottom Oneida County capped aluminum monument. See below for reference ties.

(c)(d)(e) PLAN VIEW OF CORNER WITH TIES TO AT LEAST 4 WITNESS MONUMENTS. IF IN DISAGREEMENT WITH PREVIOUSLY ESTABLISHED CORNER, SHOW THE DISTANCE BETWEEN THE TWO CORNERS AND ALSO INDICATE THE TIES TO THE DISPUTED CORNER.

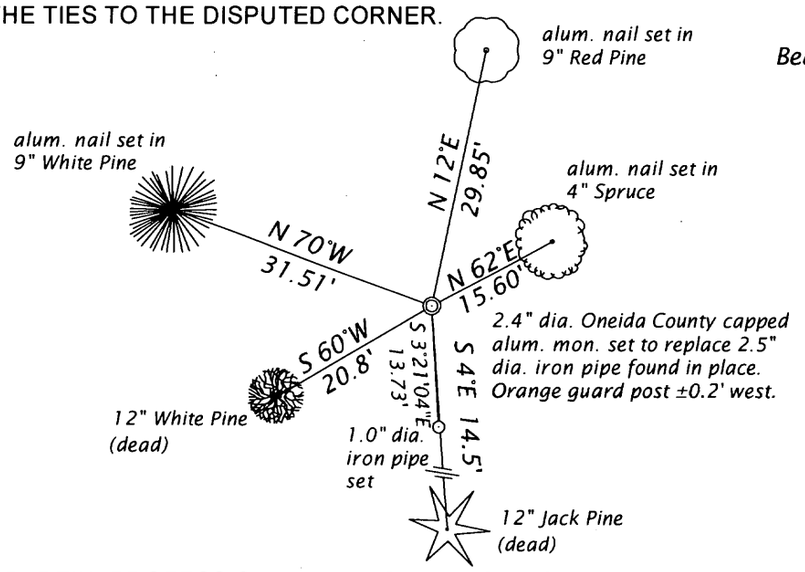

Bearing base assumed

Scale: 1" = 20'

(i) I, JAMES D. REIN, PROFESSIONAL LAND SURVEYOR NO. S-1234 HEREBY CERTIFY THAT THE CORNER LOCATION ON THIS RECORD WAS DETERMINED BY ME OR UNDER MY DIRECTION AND CONTROL AND THAT THIS U.S. PUBLIC LAND SURVEY MONUMENT RECORD IS CORRECT AND COMPLETE TO THE BEST OF MY KNOWLEDGE AND BELIEF.

3-31-15

SIGNATURE DATE

WISCONSIN
JAMES D. REIN
S-1234
MINOCQUA, WI
LAND SURVEYOR

380607 2000

INDEX NO. G-5