

CERTIFIED LAND CORNER RESTORATION

State of Wisconsin }
County of Oneida } ss.

I John H. Fisher, do hereby certify that on the 25th day of July, 1985, I found evidence of the Southeast corner of Section 15 Township 38 north, Range 6 East, Fourth Principal Meridian, as described hereon; and that from this evidence I established a new monument and accessories as described hereon to perpetuate the original location of this corner:

Description of original monument and accessories and subsequent restorations:

The original Government survey was performed by Alexander Anderson, Deputy Surveyor in 1863.

Wood Post Set:

Aspen 12" N23°E 11 lks.
White Pine 9" N70-1/2°W 11 lks.



Description of corner evidence found:

2" diameter brass tablet stamped to identify corner on 2" iron pipe.

Description of monument and accessories I established to perpetuate the original location of this corner:

Blazed and scribed the following new bearing trees
Set nails in:

Norway Pine 12" N85°E 88.60 feet
White Pine 6" N23°E 34.60 feet
Norway Pine 5" S48°W 36.60 feet
Spruce 5" S 6°W 52.50 feet

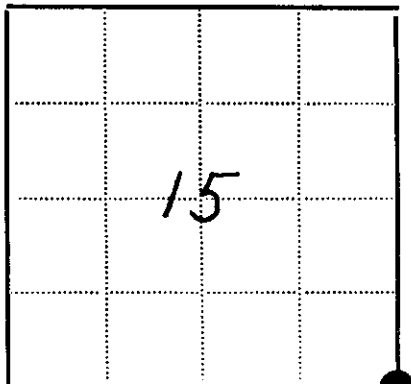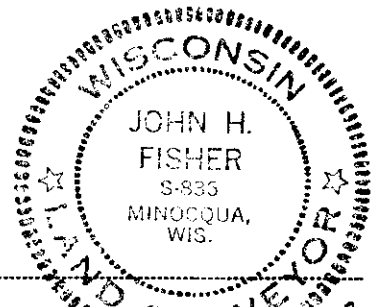

● = Corner monument restored
□ =

Resident witnesses None

Dated at Minocqua Wisconsin, this 21st day of August 1985

Signature John H. Fisher Title Registered Land Surveyor
(County Surveyor, Registered Land Surveyor, or other duly authorized official)

Surveyors Registration No. S-836

Office of County of

I hereby certify that the within instrument was filed in this office for record on the day of 19, and was filed in Book No. Page No. of County Records.

Signature Title

Township, Range, Section, Index No., Page No.

3806150000

N-11