

CERTIFIED LAND CORNER RESTORATION

State of Wisconsin }
County of Oneida } ss.

I James F. Kasson, do hereby certify that on the 9th day of June, 1981, I found evidence of the South 1/4 corner of Section 24 Township 38 North, Range 6 East, Fourth Principal Meridian, as described hereon; and that from this evidence I established a new monument and accessories as described hereon to perpetuate the original location of this corner:

Description of original monument and accessories and subsequent restorations:


Wood post BT's. 10" White Pine, S 68° 30' E, 8 lks.
9" White Pine, N 6° E, 15 lks.

Description of corner evidence found: None

Description of monument and accessories I established to perpetuate the location of this corner:

Set Oneida County aluminum monument
BT's. 9" White Pine, S 44° E, 31.27'
13" White Pine, N 83° E, 25.62'

Wood post (scribed) approx. S 2° 50' 37" E, 17.84 ft.

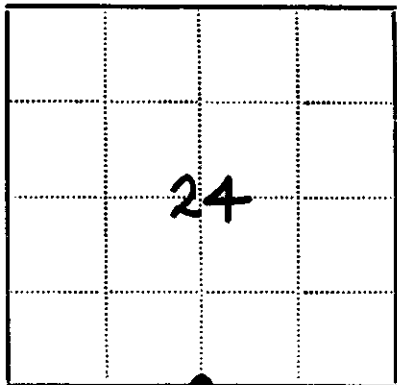

● - Corner monument restored
□ -

Resident witnesses.....

Dated at Rhineland, Wisconsin, this 7 day of July 1981

Signature James F. Kasson Title RLS
(County Surveyor, Registered Land Surveyor, or other duly authorized official)

Surveyors Registration No. 416

Office of Register of Deeds County of Oneida

I hereby certify that the within instrument was filed in this office for record on the 11 day of June 1986, and was filed in Book No. Page No. of County Records.

Signature Doris Verage Kuhn Title Register of Deeds
Deputy

Township 38 N., Range 6 E., Section 24, Index No., Page No.

3806240020