U.S. PUBLIC LAND SURVEY MONUMENT RECORD

Note: This form is intended and designed to fulfill all requirements of Wisconsin Administrative Code, Chapter A–E 7.08 U.S. Public Land Survey Monument Record (3)(a)(b)(c)(d)(e)(f)(g)(h)(i). An additional sheet may be added if necessary to conform with said requirements.

(a) CORNER LOCATION: * on south line

Meander corner* of Sec. 27

Township 38 North

Range 6 East

Town/City/Village Hazelhurst

County of Oneida

State Plane Coordinates

X _____

Y _____

Datum Base _____

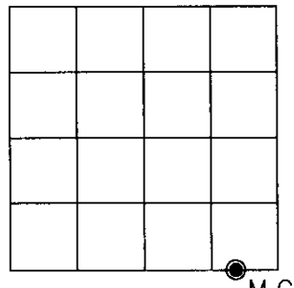

SECTION 27

(b) HISTORY OF ORIGINAL CORNER ESTABLISHMENT

Original Surveyor: Alexander Anderson

Original B.T.'S

Date of Survey: Commenced Sept. 28th, 1863 Tamarac 10" S12°E, 17 links

Completed Oct. 5th, 1863 Tamarac 8" N64°W, 20 links

(f)(g)(h) Description of monument found at this corner and if it was accepted, state all evidence (material, testimonial, occupational, plats, records, other monuments) used as a basis for establishing location. If not accepted of if nothing was found, state evidence used as basis for establishing location. If reestablished through lost corner proportionate methods, indicate all monuments, distances and directions used to establish. Indicate type of monument and sign post found or set.

Aug. 1946 - E. F. Kowalke, Surveyor - Field Book 3, page76, recovered two Tam. stumps, agreeing with Gov't. record, no marks, Set temp stake. Sept. 18, 1946, Field Book 3, page 77, measure west from M.C., 25.70 chains to plain post set for temp 1/4 Cor. set from two stumps fairly close in bearing and distance.

March 24, 1948 - Ivan Branham, Surveyor, Field 7, page 34, measure east from Kowalke's 1/4 Cor.; at 1323 feet to Colby's 1/16 Cor.; at 1638.8 feet Colby stake; at 1698 Kowalke's temp M.C.

September 27, 1974, Gerald B. Inman, R.L.S. No. 891, Plat of Warbonett Woods, identifies this meander corner being monumented by a 1" dia. iron pipe located 1624.41 feet east of the 1/4 Corner.

June 1999 to February 2001 - James D. Rein, R.L.S. No. 1234, we recovered a 1" dia. iron pipe with elbow fitting near the westerly shore of Lost Lake. This monument position corresponds with the position shown in the Plat of Warbonett Woods, however, it is approximately 70 feet short of the Kowalke and Branham measurements. Although this discrepancy exists, I believe the monument could be the "Colby stake" Branham makes reference to, and because of the severe angular intersection with the shoreline decide to accept it as the best evidence for the corner. We replace the iron pipe with a capped 2" dia. x 30" long aluminum monument with reference ties as shown in plan view.

(c)(d)(e) Plan view of corner with ties to at least 4 witness monuments. If in disagreement with previously established corner, show the distance between the two corners and also indicate the ties to the disputed corner.

Bearings Magnetic

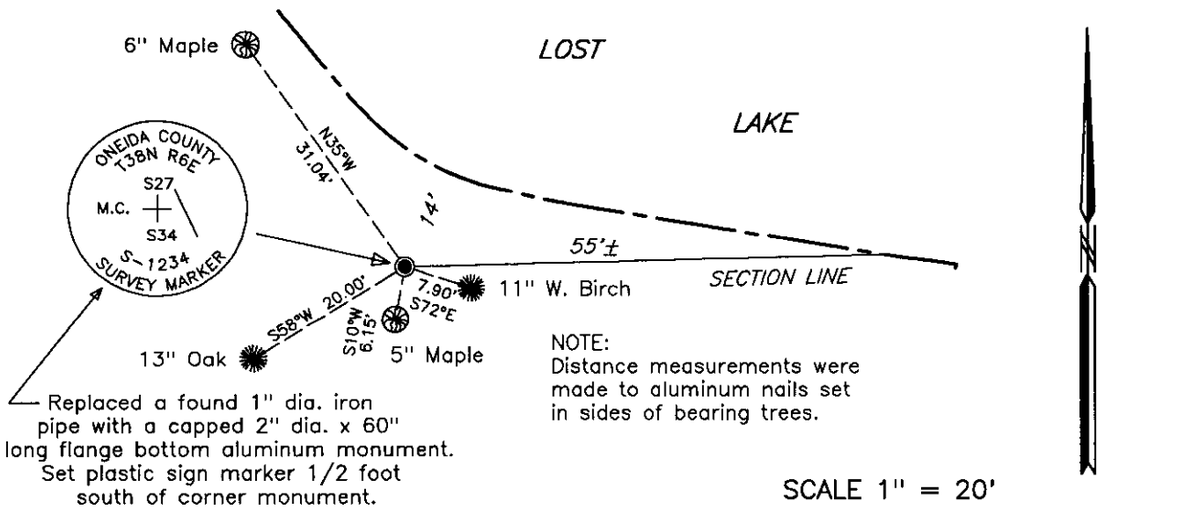

(i) I, James D. Rein, Registered Land Surveyor No. 1234, hereby certify that the corner location on this record was determined by me or under my direction and control and that this U.S. Public Land Survey Monument Record is correct and complete to the best of my knowledge and belief.

Signature

February 19, 2001

Date

WISCONSIN
JAMES D. REIN
S-1234
MINOCQUA, WI
LAND SURVEYOR

INDEX NO. V-16,17

38 06 27 D017