


U.S. PUBLIC LAND SURVEY MONUMENT RECORD

Note: This form is intended and designed to fulfill all requirements of Wisconsin Administrative Code, Chapter A-E 7.08 U.S. Public Land Survey Monument Record (3) (a) (b) (c) (d) (e) (f) (g) (h) (i). An additional sheet may be added if necessary to conform with said requirements.

(a) Corner location: Township 37 North
 Range 6 East/West

Town/City/Village Cassian

County Oneida

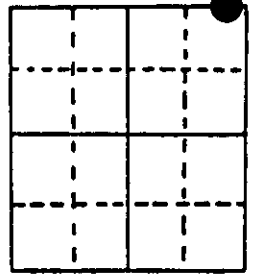

Section 6

(b) (f) (g) (h) Description of monument found at this corner and if it was accepted, state all evidence (material, testimonial, occupational, plats, records, other monuments) used as a basis for accepting. If not accepted or if nothing was found, state evidence used as basis for establishing location. If reestablished through lost corner proportionate methods, indicate all monuments, distances and directions used to establish. Indicate type of monument found or set and sign post.

1860 - Alfred Millard established this corner on West shore of lake and set a wood post with two BTs:

12" White Pine, S50°W, 29 Links (19.14') 12" White Birch, N70°W, 28 Links (18.48')


12/1/1936 - V. Maine found axle marking corner with stumps of both original BTs. He marked one new BT: 16" Red Pine, S28°E, 110¼ Links (72.76')

10/25/1995 - Milo E. Stefan found 1" x 24" axle marking corner, Maine's BT dead and stump of original Pine BT still there. We replaced 1" x 24" axle with a 2" x 30" aluminum monument, made four new BTs and placed a plastic sign post.

(c) (d) (e) Plan view of corner with ties to at least 4 witness monuments. If in disagreement with previously established corner, show the distances between the two corners and also indicate the ties to the disputed corner.

- 1) 2" x 30" Aluminum Monument. with 1" x 24" axle inside.
- 2) 18" Red Pine, S12°E, 82.45'.
- 3) 22" Red Pine, S20°W, 65.83'.
- 4) 12" Red Oak, S54°W, 39.72'.
- 5) 12" White Birch, N58°W, 30.28'.
- 6) Plastic Sign Post, West, 1.2'.

Distances to nail in side of BTs.
 Stump blaze scribed "BT".
 BT tag placed on face of each BT.

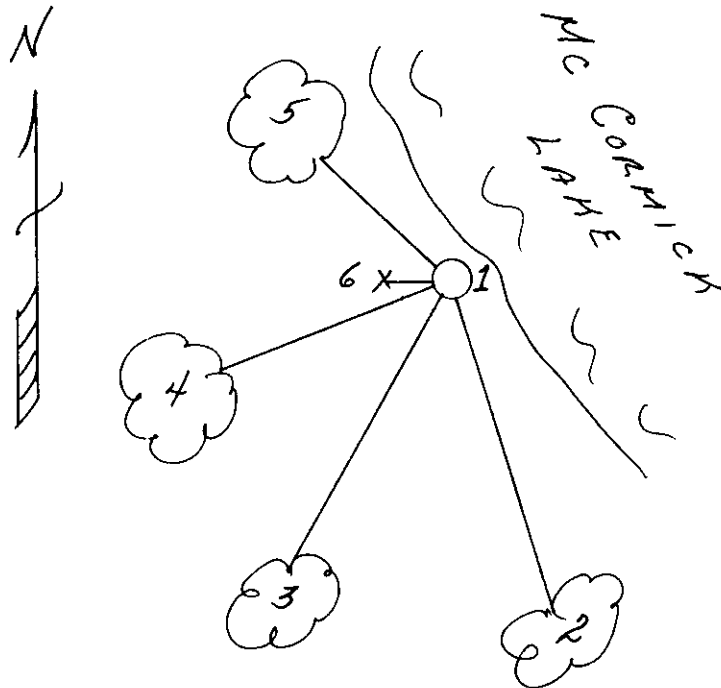

(i) I, Milo E. Stefan
 (type or print name) certify that the corner location on this record was determined by me or under my direction and control and that this U.S. Public Land Survey Monument Record is correct and complete to the best of my knowledge and belief.

Milo E. Stefan
 Signature

December 17, 1995
 Date



Stamp
 3806310001