

U.S. PUBLIC LAND SURVEY MONUMENT RECORD


Note: This form is intended and designed to fulfill all requirements of Wisconsin Administrative Code, Chapter A-E 7.08 U.S. Public Land Survey Monument Record (3) (a) (b) (c) (d) (e) (f) (g) (h) (i). An additional sheet may be added if necessary to conform with said requirements.

(a) Corner location: Township 37 North

Range 6 East/West

Town/City/Village Cassian

County Oneida

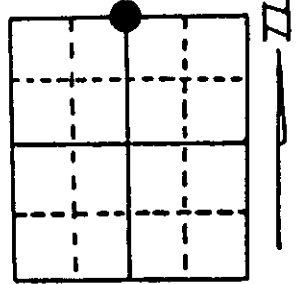

Section 6


(b) (f) (g) (h) Description of monument found at this corner and if it was accepted, state all evidence (material, testimonial, occupational, plats, records, other monuments) used as a basis for accepting. If not accepted or if nothing was found, state evidence used as basis for establishing location. If reestablished through lost corner proportionate methods, indicate all monuments, distances and directions used to establish. Indicate type of monument found or set and sign post.

- 1860 - Alfred Millard established this corner and set a wood post with two BTs:
4" Spruce Pine, N67°E, 125 Links (82.50') 10" Spruce Pine, S44°E, 50 Links (33.00')
- 1937 - V. Maine restored this corner and set a 2" x 60" iron pipe/brass cap.
- 10/27/1994 - We found Maine's monument, a 6" x 6" x 36" Cedar Post and a Location Poster on a 14" Red Pine, S78°E, 38'.
Milo E. Stefan made four new BTs and set a plastic sign post.

(c) (d) (e) Plan view of corner with ties to at least 4 witness monuments. If in disagreement with previously established corner, show the distances between the two corners and also indicate the ties to the disputed corner.

- 1) 2" x 60" Iron Pipe/Brass Cap.
- 2) 12" White Pine, N70°E, 61.78'.
- 3) 14" Red Pine, S78°E, 37.99'.
- 4) 20" White Pine, S10°W, 53.84'.
- 5) 20" White Pine, S75°W, 53.15'.
- 6) Plastic Sign Post, North, 1.0'.

Distances to nail in side of BTs.
Stump blazes scribed "BT".

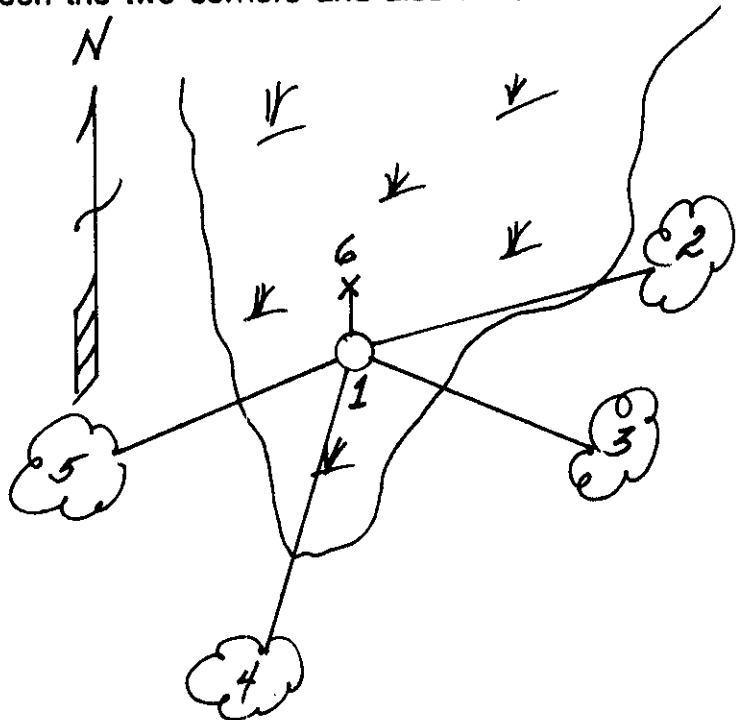

(i) I, Milo E. Stefan
(type or print name) certify that the corner location on this record was determined by me or under my direction and control and that this U.S. Public Land Survey Monument Record is correct and complete to the best of my knowledge and belief.

Milo E. Stefan
Signature

October 30, 1994
Date



Index No. A-3

3806360020