REGISTER OF DEEDS OFFICE
ONEIDA COUNTY
FILED

MAR 20 2017

AT_____O'CLOCK_____M
KYLE J. FRANSON
REGISTER OF DEEDS

U.S. PUBLIC LAND SURVEY MONUMENT RECORD

Note: This form is intended and designed to fulfill all requirements of the Wisconsin Administrative Code, Chapter A-E 7.08 U.S. Public Land MonumentRecord (3)(a)(b)(c)(d)(e)(f)(g)(h)(i). An additional sheet may be added if necessary to conform with said requirements.

(a) CORNER LOCATION:
Meander Corner East Line of Section 31
Township 38 North
Range 6 East
Town of Hazelhurst
County of Oneida

COORDINATES
North: 200537.408
East: 170724.648
Projection: WISCORS - Oneida
Datum: NAD 1983(2011)
Method: RTK

(RECORDING AREA)

SECTION 31

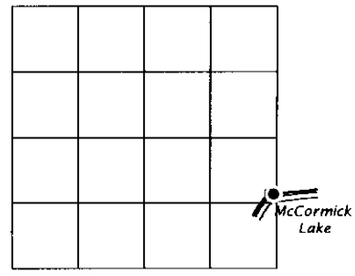

(b) HISTORY OF ORIGINAL CORNER ESTABLISHMENT
Original Surveyor: Alexander Anderson
Date of Survey: Commenced September 28, 1863
Completed October 5, 1863
Original B.T.'S: 8" Aspen, N 58°W, 15 lks.
7" Birch, N 42°E, 57 lks.

(f)(g)(h) DESCRIPTION OF MONUMENT FOUND AT THIS CORNER AND IF IT WAS ACCEPTED, STATE ALL EVIDENCE (MATERIAL, TESTIMONIAL, OCCUPATIONAL, PLATS, RECORDS, OTHER MONUMENTS) USED AS A BASIS FOR ESTABLISHING LOCATION. IF NOT ACCEPTED OR IF NOTHING WAS FOUND, STATE EVIDENCE USED AS BASIS FOR ESTABLISHING LOCATION. IF REESTABLISHED THROUGH LOST CORNER PROPORTIONATE METHODS, INDICATE ALL MONUMENTS, DISTANCES AND DIRECTIONS USED TO ESTABLISH. INDICATE TYPE OF MONUMENT AND SIGN POST FOUND OR SET.

1964 - William H. Stuth, in a joint survey between O-I and NEPCO, surveyed and subdivided Section 31 . On a subsequent survey, dated 8/20/86, he shows an iron pipe or cap at the meander corner location. He shows two BT's: 14" W. Pine, N 58°E, 37.2' and a 4" Maple, N24°W, 13.6'.

2015 - While surveying in Section 32, Theodore G. Sommer set a 1.0" dia. 24" long iron pipe at the meander corner location He measeured1272.45' north to the quarter corner. See Oneida County Surveyor's Office Map No. B7761.

2015 - While surveying in Section 31, James D. Rein found and accepted a 1.0" dia. iron pipe at the meander corner location. See our Map No. 15 - 176, dated October 22, 2015. We replaced the 1.0" dia. iron pipe found with an Oneida County 2.4" dia. x 30" long, flanged-bottom, aluminum monmunt. See reference ties below.

(c)(d)(e) PLAN VIEW OF CORNER WITH TIES TO AT LEAST 4 WITNESS MONUMENTS. IF IN DISAGREEMENT WITH PREVIOUSLY ESTABLISHED CORNER, SHOW THE DISTANCE BETWEEN THE TWO CORNERS AND ALSO INDICATE THE TIES TO THE DISPUTED CORNER.

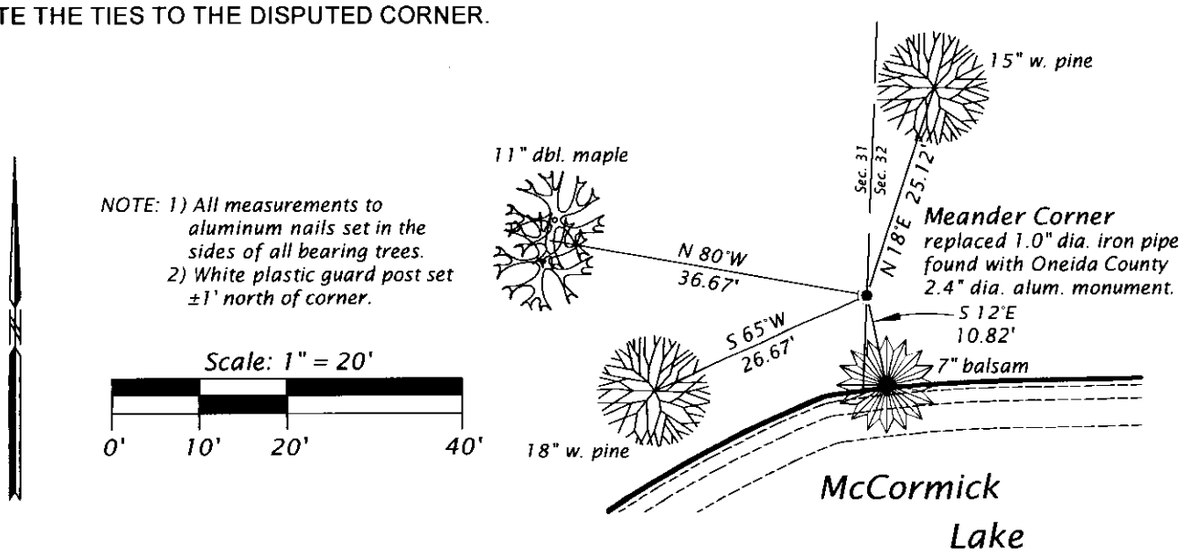

(i) I, JAMES D. REIN, PROFESSIONAL LAND SURVEYOR NO. S-1234 HEREBY CERTIFY THAT THE CORNER LOCATION ON THIS RECORD WAS DETERMINED BY ME OR UNDER MY DIRECTION AND CONTROL AND THAT THIS U.S. PUBLIC LAND SURVEY MONUMENT RECORD IS CORRECT AND COMPLETE TO THE BEST OF MY KNOWLEDGE AND BELIEF.

10-22-15

SIGNATURE DATE

WISCONSIN
JAMES D. REIN
S-1234
MINOCQUA, WI
LAND SURVEYOR

380631110

INDEX NO. XY-5