

# U.S. PUBLIC LAND SURVEY MONUMENT RECORD


**Note:** This form is intended and designed to fulfill all requirements of Wisconsin Administrative Code, Chapter A-E 7.08 U.S. Public Land Survey Monument Record (3) (a) (b) (c) (d) (e) (f) (g) (h) (i). An additional sheet may be added if necessary to conform with said requirements.

(a) Corner location: Township 37 North

Range 6 East/West

Town/City/Village Cassian

County Oneida

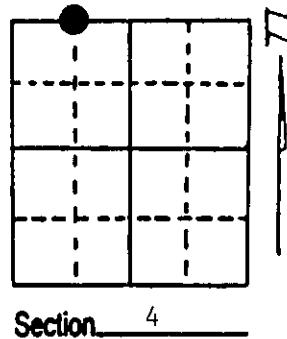

(b) (f) (g) (h) Description of monument found at this corner and if it was accepted, state all evidence (material, testimonial, occupational, plats, records, other monuments) used as a basis for accepting. If not accepted or if nothing was found, state evidence used as basis for establishing location. If reestablished through lost corner proportionate methods, indicate all monuments, distances and directions used to establish. Indicate type of monument found or set and sign post.

12/3/1936 - Vern Maine set a Tamarack Post for this corner and made two BTs:  
 5" White Pine, S42°E, 93 Links (61.38')  
 4" White Pine, South, 118 3/4 Links (78.375')


11/21/1996 - We found remains of Maine's BTs and point of his post. S42°E a dead snag and South a 12" White Pine windthrow.

11/22/1996 - We placed a 2" x 60" aluminum monument along side of Maines post point, made four new BTs and set a plastic sign post.

(c) (d) (e) Plan view of corner with ties to at least 4 witness monuments. If in disagreement with previously established corner, show the distances between the two corners and also indicate the ties to the disputed corner.

- 1) 2" x 60" Aluminum Monument/Post Point.
- 2) 10" White Pine Snag, S42°E, 61.38'.
- 3) 12" White Pine Windthrow, South, 78'.
- 4) 6" Tamarack, N13°E, 32.08'.
- 5) 8" Tamarack, N68°E, 24.70'.
- 6) 6" Tamarack, S42°E, 43.51'.
- 7) 6" Tamarack, N40°W, 51.44'.
- 8) Plastic Sign Post, South, 1.0'.

Distances to nail in side of BTs.  
 Stump blaze scribed "BT".

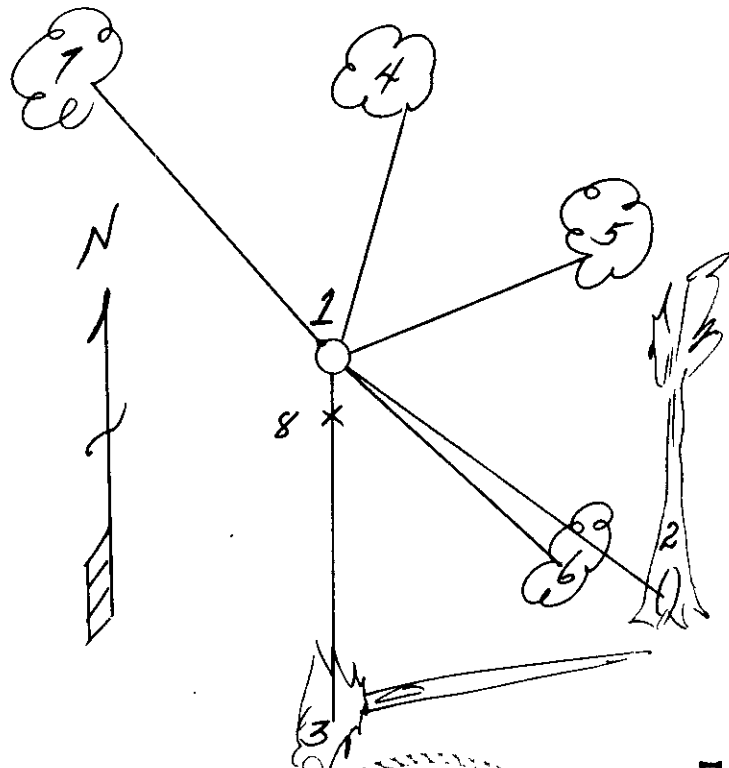

(i) I, Milo E. Stefan  
 (type or print name) certify that the corner location on this record was determined by me or under my direction and control and that this U.S. Public Land Survey Monument Record is correct and complete to the best of my knowledge and belief.

Milo E. Stefan December 9, 1996  
 Signature Date



Stamp  
 3806 3300 30

Index No. A-10