

**U.S. PUBLIC LAND SURVEY MONUMENT RECORD**

Note: This form is intended and designed to fulfill all requirements of Wisconsin Administrative Code, Chapter A-E 7.08 U.S. Public Land Survey Monument Record (a) (b) (c) (d) (e) (f) (g) (h) (i). An additional sheet may be added if necessary to conform with said requirements.

(a) Corner location: Township 38 North

Range 7 East

Town of Lake Tomahawk

Oneida County, Wisconsin



**Section 5**

(b) (i) (ii) Description of monument found at this corner and if it was accepted, state all evidence (material, testimonial, occupational, plats, records, other monuments) used as a basis for accepting. If not accepted or if nothing was found, state evidence used as basis for establishing location. If reestablished through lost corner proportionate methods, indicate all monuments, distances and directions used to establish. Indicate type of monument found or set and sign post.


August, 1867: Alexander Anderson, US deputy surveyor notes the following: 60.00 set post for corner to secs 5,6,7&8: birch 10' N11-1/2E, 17 lbs; hemlock 10' N37-1/2W, 30 lbs.

October 29, 1990: I found and accepted a 2" dia. iron post with 6.0 brass cap 10' above the ground marked as shown below. I found the following witnesses: aspen 4' E75W, 3.5 feet; set nail in oak 14" N24W, 14.67 feet; set nail in maple 7" N37E, 29.67 feet; set nail in w.pine 5' S89E, 33.88 feet; dying oak 12' S73E, 33.2 feet. I established the following witnesses: set nail in w.pine 7" S40W, 28.44 feet; set plastic sign post north, 1 foot.

(c) (i) (ii) Plan view of corner with ties to at least four witness monuments. If in disagreement with previously established corner, show the distances between the two corners and also indicate the ties to the disputed corner.

- 1. nail in oak 14" N24W, 14.67 feet.
- 2. nail in maple 7" N37E, 29.67 feet.
- 3. nail in w.pine 5" S89E, 33.88 feet.
- 4. nail in w.pine 7" S40W, 28.44 feet.

(not to scale)

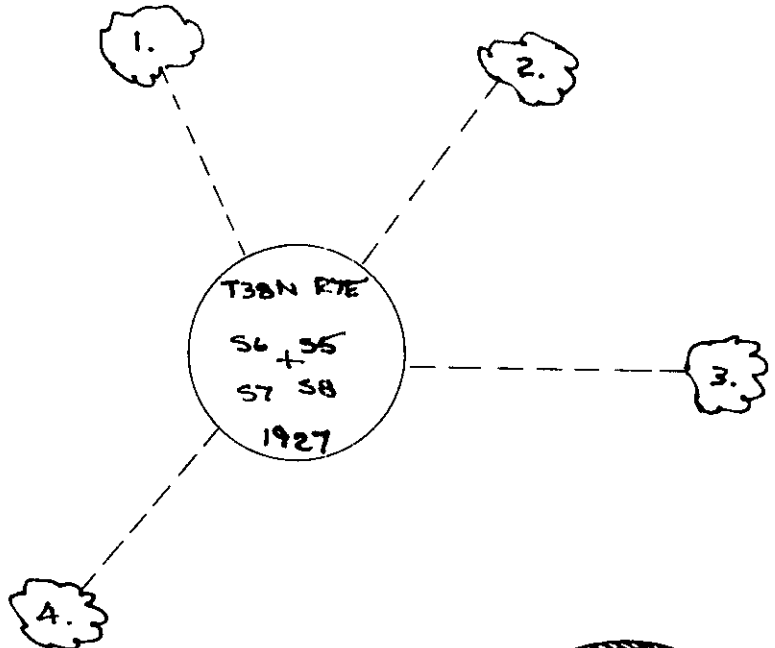

I, Jeffrey W. Austin, Registered Land Surveyor E-1885 certify that the corner location on this record was determined by me or under my direction and control and that this U.S. Public Land Survey Monument Record is correct and complete to the best of my knowledge and belief.



*Jeffrey W. Austin*  
 OCTOBER 30, 1990  
 11-11-90

Index no. E-5

3807060000