

U.S. PUBLIC LAND SURVEY MONUMENT RECORD


Note: This form is intended and designed to fulfill all requirements of Wisconsin Administrative Code, Chapter A-E 5.02, U.S. Public Land Survey Monument Record (3) (a) (b) (c) (d) (e) (f) (g) (h) (i). An additional sheet may be added if necessary to conform with said requirements.

(a) Corner location: Township 38 North

Range 7 East ~~11~~

Town/City/Village Lake Tomahawk

County Oneida

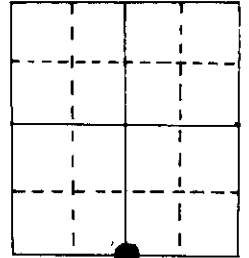

Section 13

(b) (f) (g) (h) Description of monument found at this corner and if it was accepted, state all evidence (material, testimonial, occupational, plats, records, other monuments) used as a basis for accepting. If not accepted or if nothing was found, state evidence used as basis for establishing location. If reestablished through lost corner proportionate methods, indicate all monuments, distances and directions used to establish.

Original by A. Anderson, 1863, OBT's PY 24" S65°E 23 lks., spruce 8" N77°W 37 lks.
Set at 40.40 ch/ 40.40 ch

Seymour & Copp, 1982, set ¼ at half-way on line between SW 13 & SE 13.
Set DNR brass cap, 2" i.p.

(c) (d) (e) Plan view of corner with ties to at least 4 witness monuments. If in disagreement with previously established corner, show the distances between the two corners and also indicate the ties to the disputed corner.

8" black spruce

4" black spruce

12" white pine

West 13.60'

N36°W 23.45'

N50°E 11.75'

2" i.p.
DNR brass cap
S18°E 6.65'


12" tamarack

distance to face

(i) I, Marvin E. Seymour

(type or print name) certify that the corner location on this record was determined by me or under my direction and control and that this U.S. Public Land Survey Monument Record is correct and complete to the best of my knowledge and belief.

Marvin E. Seymour Signature Feb. 19, 1988 Date

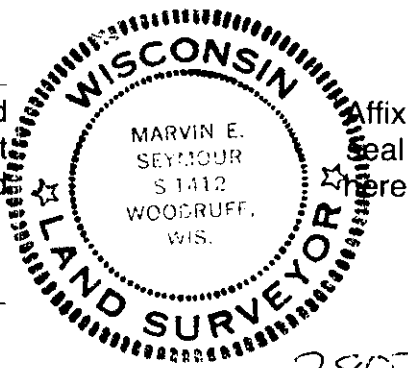

3807130020