U.S. PUBLIC LAND SURVEY MONUMENT RECORD

Note: This form is intended and designed to fulfill all requirements of Wisconsin Administrative Code, Chapter A-E 5.02, U.S. Public Land Survey Monument Record (3) (a) (b) (c) (d) (e) (f) (g) (h) (i). An additional sheet may be added if necessary to conform with said requirements.

(a) Corner location: Township 38 North

Range 7 East/~~West~~

Town/City/Village Lake Tomahawk

County Oneida

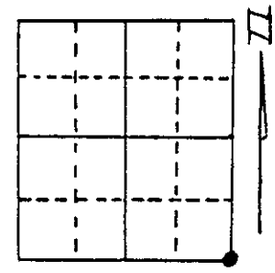

Section 14

(b) (f) (g) (h) Description of monument found at this corner and if it was accepted, state all evidence (material, testimonial, occupational, plats, records, other monuments) used as a basis for accepting. If not accepted or if nothing was found, state evidence used as basis for establishing location. If reestablished through lost corner proportionate methods, indicate all monuments, distances and directions used to establish.

6" X 6" Square concrete monument with 3-1/2" diameter brass tablet stamped to identify corner and also stamped original corner. Fall 1933

White Pine	28"	N75°E	14.9 feet
White Pine	13'	N56°E	28.2 feet
Jack Pine	11"	S29°W	19.5 feet
Jack Pine	6"	S87°W	36.8 feet

(c) (d) (e) Plan view of corner with ties to at least 4 witness monuments. If in disagreement with previously established corner, show the distances between the two corners and also indicate the ties to the disputed corner.

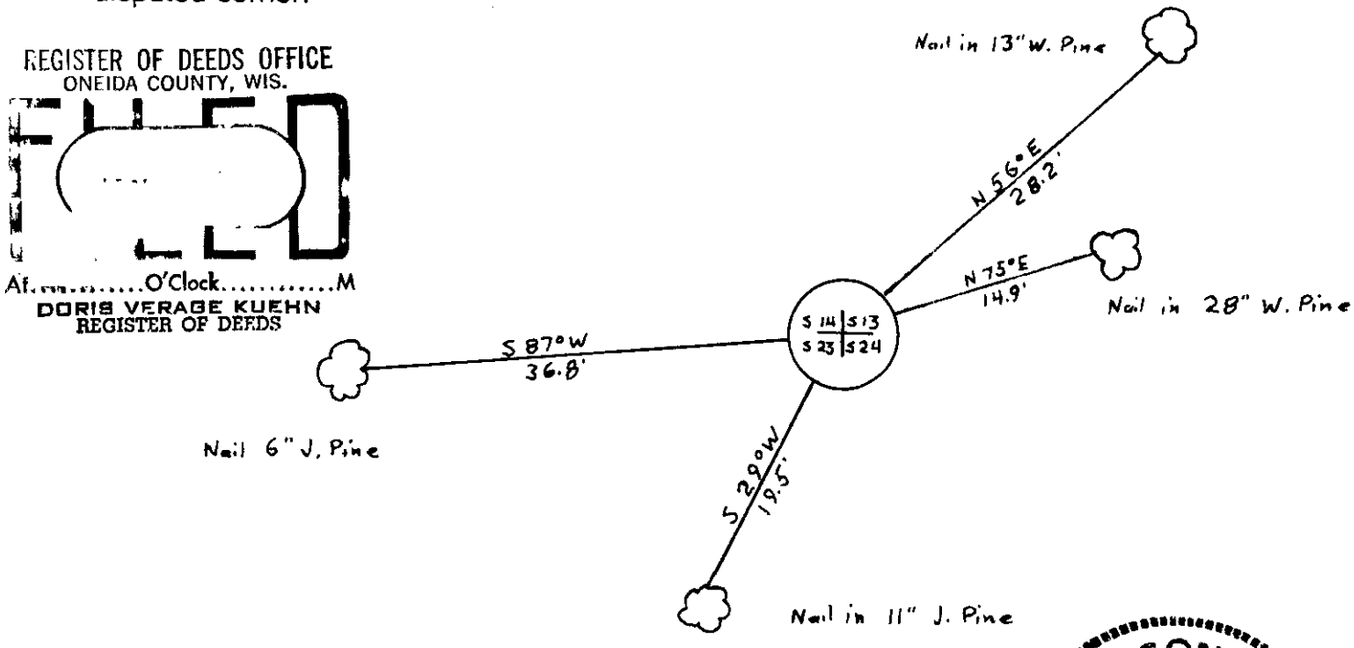

(i) I, Dennis B. Roberts (type or print name) certify that the corner location on this record was determined by me or under my direction and control and that this U.S. Public Land Survey Monument Record is correct and complete to the best of my knowledge and belief.

Dennis B. Roberts 12-24-86

Signature Date

WISCONSIN DENNIS B. ROBERTS LAND SURVEYOR

Index No. N 21

35C7140000