U.S. PUBLIC LAND SURVEY MONUMENT RECORD

Note: This form is intended and designed to fulfill all requirements of Wisconsin Administrative Code, Chapter A-E 5.02, U.S. Public Land Survey Monument Record (3) (a) (b) (c) (d) (e) (f) (g) (h) (i). An additional sheet may be added if necessary to conform with said requirements.

(a) Corner location: Township 38 North

Range 7 East/~~West~~

Town/~~City~~/~~Village~~ LAKE TOMAHAWK

County ONEIDA

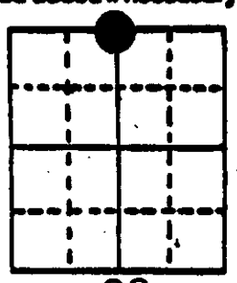

Section 22

(b) (f) (g) (h) Description of monument found at this corner and if it was accepted, state all evidence (material, testimonial, occupational, plats, records, other monuments) used as a basis for accepting. If not accepted or if nothing was found, state evidence used as basis for establishing location. If reestablished through lost corner proportionate methods, indicate all monuments, distances and directions used to establish.

- 1863 Alexander Anderson Estab. original corner...west between 15 & 22 1.50 leave lake; 40.00 set ¼ corner Tamerack 14 S40E8, maple 6 N28E7;66.50 Lake set m.c.
- 1949 F.R. Wincentsen Oneida County Surveyor states he set an iron pipe for ¼ corner at intersection of fences, B.T.s Maple 6N20E 5.0', 8" maple S25W47.
- 1954 R.E. Bandow recovered F.R. Wincentsens corner.
- 1965 J. Griffin recovered corner B.T.s 7" maple N18E 5.0', 7" maple S23W47.7'.
- 1976 Sy Poskie found 3" iron pipe at corner.
- 1987 At the corner I found a 3" O.D. iron pipe with Griffins B.T.s in place and the remains of an old down fence running North & West from the corner. I replaced the iron pipe with a 2" X 30" split base Oneida County Aluminum Capped monument, placing a Deep-I magnet in the hole, and witnessed the monument as shown below.

(c) (d) (e) Plan view of corner with ties to at least 4 witness monuments. If in disagreement with previously established corner, show the distances between the two corners and also indicate the ties to the disputed corner.

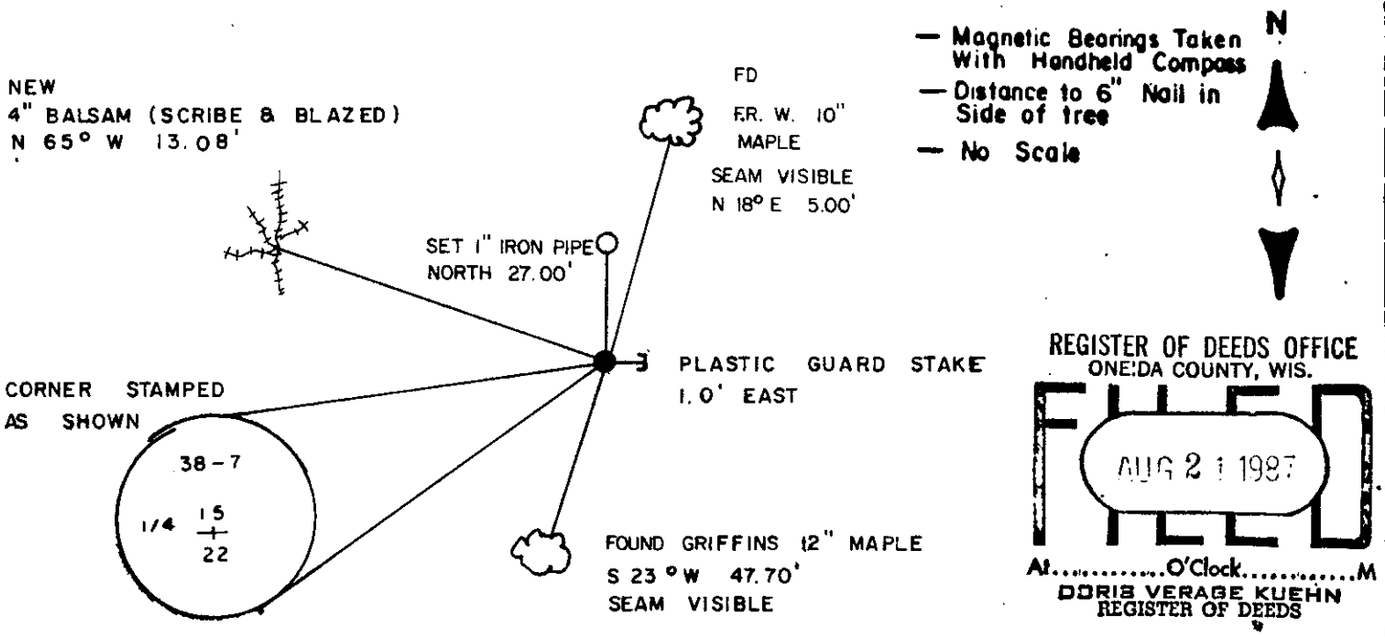

REGISTER OF DEEDS OFFICE
ONEIDA COUNTY, WIS.
FILED
AUG 21 1987
At.....O'Clock.....M
DORIS VERAGE KUEHN
REGISTER OF DEEDS

(i) I, Michael J. Romportl
(type or print name) certify that the corner location on this record was determined by me or under my direction and control and that this U.S. Public Land Survey Monument Record is correct and complete to the best of my knowledge and belief.

Michael J. Romportl 7-10-87
Signature Date

GENISOT & ASSOCIATES INC.
1512 EAGLE ST., RHINELANDER, WIS.

MICHAEL J. ROMPORTL S-1524 RHINELANDER, WI LAND SURVEYOR

Index No. N-1-U1

3807150020