

U.S. PUBLIC LAND SURVEY MONUMENT RECORD

Note: This form is intended and designed to fulfill all requirements of Wisconsin Administrative Code, Chapter A-E 5.02, U.S. Public Land Survey Monument Record (3) (a) (b) (c) (d) (e) (f) (g) (h) (i). An additional sheet may be added if necessary to conform with said requirements.

(a) Corner location: Township 30 North
 Range 7 East ~~West~~
 Town/Range Lake Tomahawk
 County Oneida

REGISTER OF DEEDS OFFICE
ONEIDA COUNTY, WIS.

FILED

DEC 4 1987

At 8:20 O'clock P.M.
DORIS VERAGE KUEHN
REGISTER OF DEEDS

Section 21


(b) (f) (g) (h) Description of monument found at this corner and if it was accepted, state all evidence (material, testimonial, occupational, plats, records, other monuments) used as a basis for accepting. If not accepted or if nothing was found, state evidence used as basis for establishing location. If reestablished through lost corner proportionate methods, indicate all monuments, distances and directions used to establish.

Original by A. Anderson, 1863, OBT's oak 5''S88°W 33 lks., mp15''N59°W 38 lks.
 at 39.36 ch. east from NW 21

1929, W. Cook of GLO Resurvey, set a GLO brass cap at 38.22 ch. east from
 proportioned NW 21. BT's made PN 6''S76°W 73 lks.
 PN 8''N67°W 43 lks.


Seymour, in 1985 & 1987, used GLO brass cap. In 1987 went to make new BT's and
 found RR spikes in 2 trees, PN 27''N59°W 27.47' (must be GLO's Resurvey)
 OR 16''S37°W 36.61'
 made two other new BT's.

(c) (d) (e) Plan view of corner with ties to at least 4 witness monuments. If in disagreement with previously established corner, show the distances between the two corners and also indicate the ties to the disputed corner.

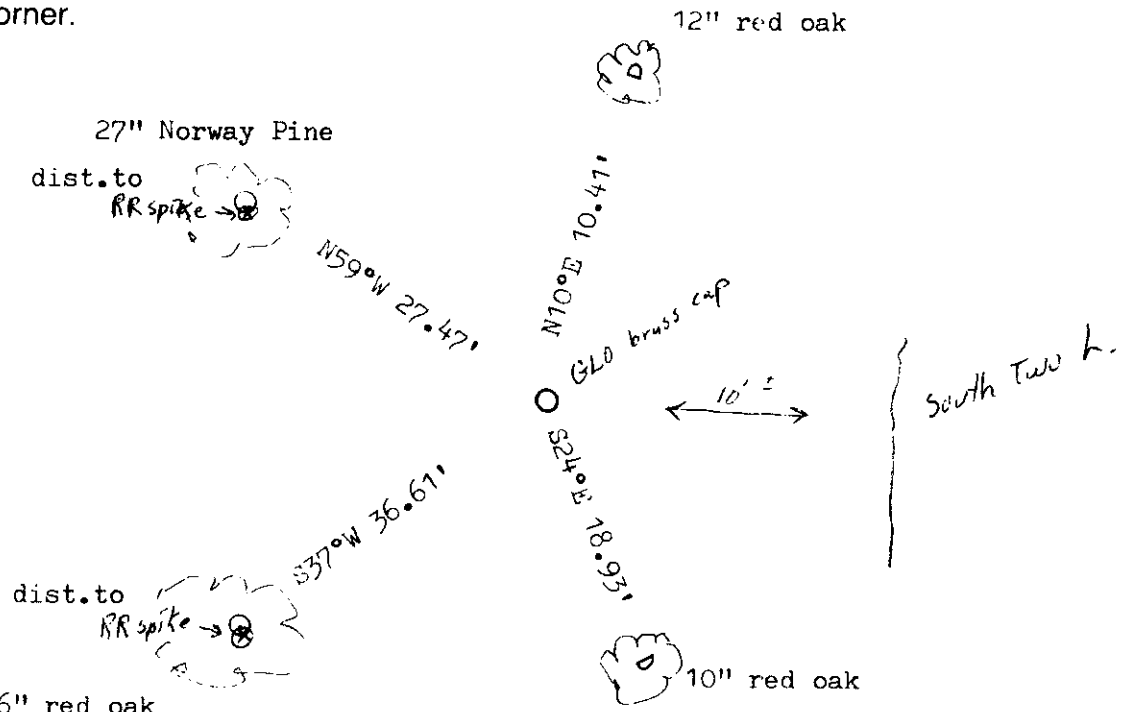

(i) I, Marvin E. Seymour
 (type or print name) certify that the corner location on this record was determined by me or under my direction and control and that this U.S. Public Land Survey Monument Record is correct and complete to the best of my knowledge and belief.

Marvin E. Seymour Signature Dec. 3, 1987 Date

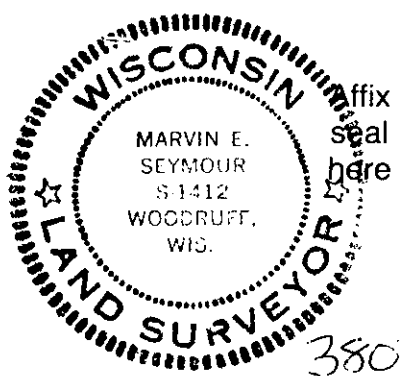

3807160022

Z-10-11