U.S. PUBLIC LAND SURVEY MONUMENT RECORD

Note: This form is intended and designed to fulfill all requirements of Wisconsin Administrative Code, Chapter A-E 5.02, U.S. Public Land Survey Monument Record (3) (a) (b) (c) (d) (e) (f) (g) (h) (i). An additional sheet may be added if necessary to conform with said requirements.

(a) Corner location: Township 38 North

Range 7 East

Town/City/Village Lake Tomahawk

County Oneida

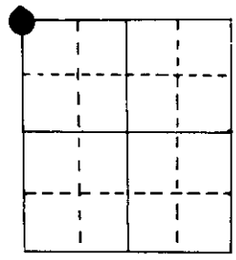

Section 21

(b) (f) (g) (h) Description of monument found at this corner and if it was accepted, state all evidence (material, testimonial, occupational, plats, records, other monuments) used as a basis for accepting. If not accepted or if nothing was found, state evidence used as basis for establishing location. If reestablished through lost corner proportionate methods, indicate all monuments, distances and directions used to establish.

Original by A. Anderson, 1863, OBT's mpl 6" N8°W 13 lks., Asp N 44°E 15 lks.

1929, GLO Resurvey, set proportioned corner. (2 ch. error found later, see below)

1965, Griffin set 2" iron pipe 2 ch. easterly based on Ivan Hassler's 1940's survey found the 2 ch. error.

Seymour, 1985 & 1987 used the 2" i.p. by Griffin. Made new BT's in 1987.

(c) (d) (e) Plan view of corner with ties to at least 4 witness monuments. If in disagreement with previously established corner, show the distances between the two corners and also indicate the ties to the disputed corner.

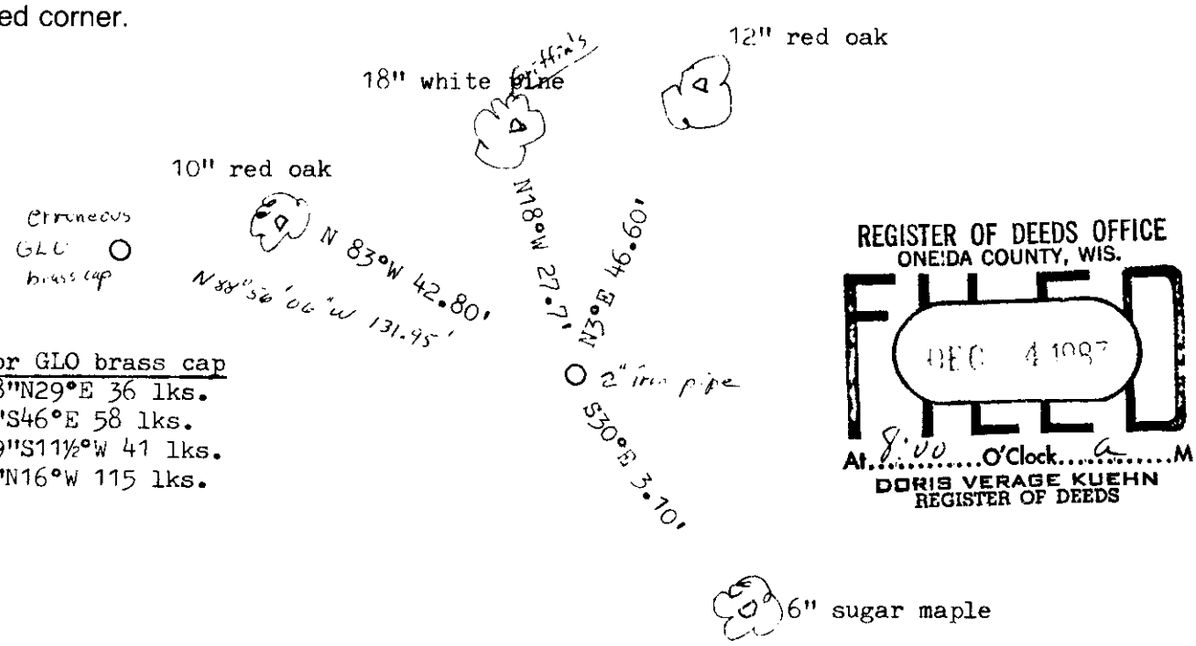

1929
BT's for GLO brass cap
asp 8"N29°E 36 lks.
PW 7"S46°E 58 lks.
asp 9"S11½°W 41 lks.
PN 6"N16°W 115 lks.

REGISTER OF DEEDS OFFICE
ONEIDA COUNTY, WIS.
FILED
DEC 4 1987
At 8:00 O'Clock a M
DORIS VERAGE KUEHN
REGISTER OF DEEDS

(i) I, Marvin E. Seymour
(type or print name) certify that the corner location on this record was determined by me or under my direction and control and that this U.S. Public Land Survey Monument Record is correct and complete to the best of my knowledge and belief.

Affix seal here

WISCONSIN
MARVIN E. SEYMOUR
S-1412
WOODRUFF, WIS.
LAND SURVEYOR

Marvin E. Seymour — Dec 3, 1987
Signature — Date

N-10

3807170000