U.S. PUBLIC LAND SURVEY MONUMENT RECORD

Note: This form is intended and designed to fulfill all requirements of Wisconsin Administrative Code, Chapter A-E 7.08 U.S Public Land Survey Monument Record (3) (a) (b) (c) (d) (e) (f) (g) (h) (i). An additional sheet may be added if necessary to conform with said requirements.

(a) Corner location: Township 38 North

Range 7 East/~~West~~

Town/City/Village Lake Tomahawk

County Oneida

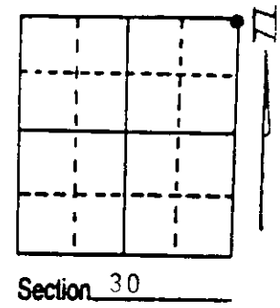

(b) (f) (g) (h) Description of monument found at this corner and if it was accepted, state all evidence (material, testimonial, occupational, plats, records, other monuments) used as a basis for accepting. If not accepted or if nothing was found, state evidence used as basis for establishing location. If reestablished through lost corner proportionate methods, indicate all monuments, distances and directions used to establish. Indicate type of monument found or set and sign post.

1863-Anderson set post 10" birch N 33½ W, 7 links, 10" birch South 86 East, 10 links
1956-Berdt found old B.T.s and well cylinder in place, B.T.s are red oak 16", S 60 W, 29', white birch 5", N 40 E 49'
1981-Seymour Vissers found old B.T.s and well cylinder in place, found brass cap south of pond, B.T.s are white birch 8", N 40 E, 31.20' red oak 30" S 60 W, 19.35'
1993-William Bandow found 2" capped iron pipe, found 30" red oak, S 60 W, 19.35', old B.T. made new B.T.s 4" maple, S 48 E, 15.02', 8" maple, N 75 W, 38.41', 3" balsam, N 5 E, 19.10' and witnessed as shown below:

(c) (d) (e) Plan view of corner with ties to at least 4 witness monuments. If in disagreement with previously established corner, show the distances between the two corners and also indicate the ties to the disputed corner.

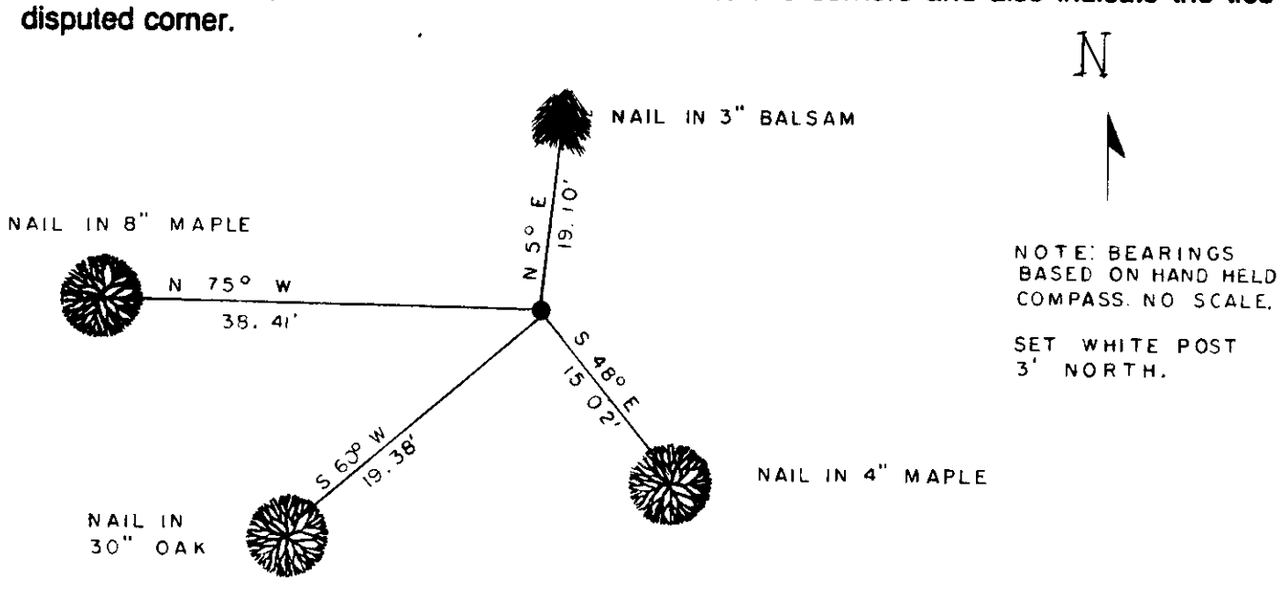

(i) I, William E. Bandow (type or print name) certify that the corner location on this record was determined by me or under my direction and control and that this U.S. Public Land Survey Monument Record is correct and complete to the best of my knowledge and belief.

William E Bandow 12-29-93

Signature Date

WISCONSIN
WILLIAM E. BANDOW
S-1182
RHINELANDER, WI
LAND SURVEYOR

Index No. R-5

3807 190000

Stamp