

At _____ O'Clock _____ M
THOMAS H. LEIGHTON
REGISTER OF DEEDS

This form is intended to fulfill the requirements of Chapter A-E7.08 (3)(a) thru (i) U.S. Public Land Survey Monument Location Record, Wisconsin Administrative Code. Use the reverse side of form for continuation.

U.S. PUBLIC LAND SURVEY MONUMENT LOCATION RECORD

Recorders Data

USPLS CORNER: EAST WITNESS MC SECTION: 29 TOWNSHIP: 38 NORTH RANGE: 7 EAST
NAME OF WATERWAY FOR M.C. CORNER: WIND PUDDING LAKE SECTION LINE: NORTH
~~(CITY)(VILLAGE)~~(TOWN) OF: LAKE TOMAHAWK COUNTY OF: ONEIDA

Description of monument found or placed and all other evidence used as the basis for monument location; including monuments and measurements required if the corner location was reestablished by lost corner proportionate methods. Also indicate name of the original surveyor, original survey date and the corner monument, bearing trees, witness or other reference monuments established, including measured bearing and distance ties, from available survey records.

No original MC set by Alexander Anderson in August 1863 per GLO notes.

On WindPudding Shores subdivision plat by James G. Griffin/RLS 755 filed in Oneida County records, he notes a 2" dia. iron pipe as this Witness MC and a 10" Oak BT S06°W 18.5'.


On June 29, 2006, I found the 2" dia. iron pipe flush at grade at Northerly edge of brushy woods and S45E 22'+/- from bank of a narrow connecting lakes channel bearing N45°E+/-; I also found the plat noted BT as NE trunk of a double 12" Oak with lower blaze scar plain., which I painted orange and nailed a standard BT sign to upper face.

I carefully pulled the old 28" long iron pipe and drove a standard 2" dia. x 30" long aluminum monument with stamped Oneida County cap into the soil cavity of old iron pipe to 3" above grade and I placed 3 nearby rocks as a cairn around the monument.

Corner falls at NW corner of Lot 24 of subject plat at Fire No. 8690 South Wind Pudding Drive.

There were no direct witnesses.

Plan view map of monument location with bearing and distance ties to a minimum of four(4) described witness or reference monuments of concrete, natural stone, iron, live bearing trees or equivalent material. If applicable, also show a minimum of two(2) bearing and distance ties to any other monument found and not accepted; including the bearing and distance from the accepted monument.

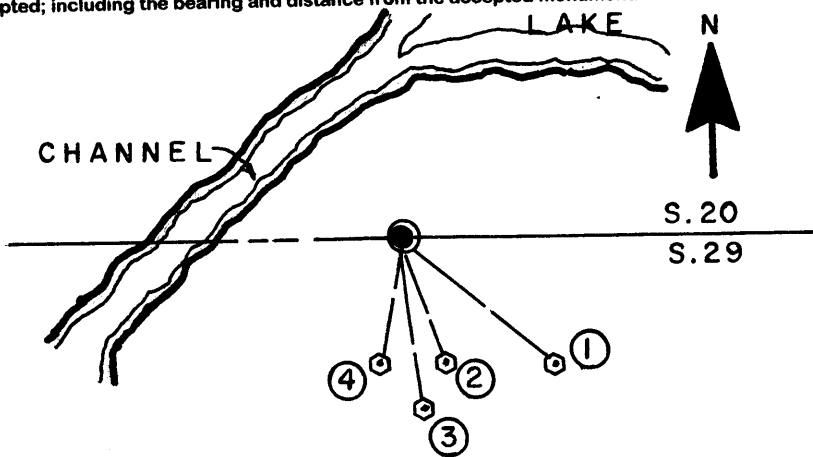

WITNESS MONUMENT TIES:

- ① New 7" SW trunk of double Mr BT S50°E 30.99'.
- ② New 9" Mr BT bent NE S20°E 20.72'.
- ③ New 7" Oak BT S08°E 27.14'.
- ④ Old 12" NE trunk of double Oak BT S10°W 19.96'.

I set a standard white poly 'T' marker post 1.0' North of new monument.

SCALE: 1" = 30'

Unless otherwise indicated, all bearing tree ties are to a .25" dia. by 2.5" long PK nail with a 1.25" dia. steel washer driven into unblazed right face and a .25" dia. by 2.5" long PK nail with a 2" dia. steel washer stamped BT is also driven into unblazed face of bearing tree at DBH; the basis for measured bearings is by compass to nearest degree and all tie distances are measured horizontal by steel tape corrected to nearest 1/100th feet at standard temperature of 68° F.


RLS SEAL:



LAND SURVEYOR CERTIFICATE:

I, William C. Rohde, hereby certify that I am duly licensed as a Professional Land Surveyor in the State of Wisconsin; that this USPLS monument location was determined by me and/or under my direct supervision and control; and that this U.S. Public Land Survey Monument Location Record is true and correct to the best of my knowledge and belief.

Signed: *William C. Rohde*
William C. Rohde RLS 841

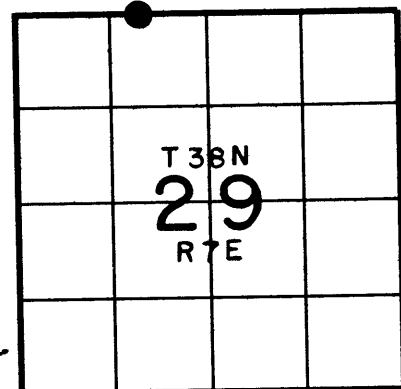

SECTION LOCATION MAP
INDEX NO. R 6-7

3807200026